SEC 29 23
SWS 29 23

FROM THE OFFICE OF

CHARLES O. GEORGI COMPANY

2215 West County Road B — Saint Paul 8, Minnesota

REGISTERED CIVIL ENGINEER AND LAND SURVEYOR

Certificate of Survey

For: Rehbein-Hosnik-Vadnais Const., and Whom it may concern

I Hereby Certify that this plat shows a building location survey made by me on the property described on this plat, and that all locations, have been correctly shown.

Date November 24, 1967

Scale 1" = 100'

By Charles O. Georgi
REGISTERED LAND SURVEYOR

Description:

That part of the NE 1/4 of the SE 1/4, Section 6, T29N, R23W, 4th P.M. lying South of a line parallel to the North line of said quarter-quarter and 525 feet South thereof measured along the East line thereof, lying North of a line parallel to the North line of said quarter-quarter and 863.9 feet South thereof measured along the East line thereof and lying Easterly of the SE'ly line of old U.S. Highway 8, Hennepin County, Minn.

Driveway Description:

The South 30 feet of the North 45 feet; the South 45 feet of the North 90 feet of the West 40 feet of the East 140 feet; and the South 24 feet of the North 114 feet of the East 140 feet; - of the above described parcel of land.

North line of NE 1/4 of SE 1/4 of Section 6 T29N, R23W

North line of NW 1/4 of SW 1/4 of Section 5 T29N, R23W

Description:
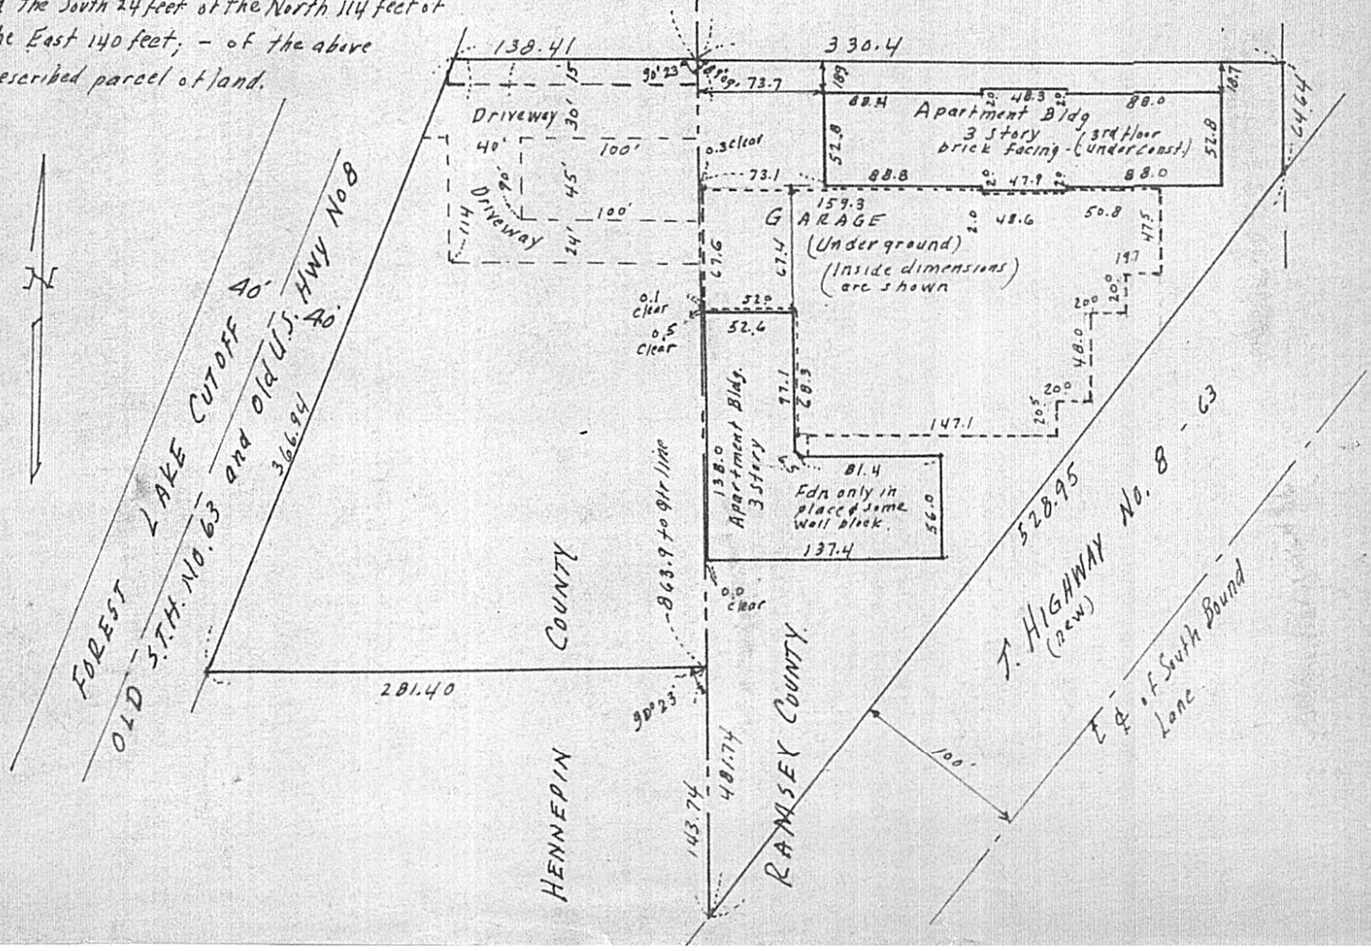
That part of the NW 1/4 of the SW 1/4, Section 5, T29N, R23W, 4th P.M. lying South of a line parallel to the North line of said quarter-quarter and 525 feet South thereof measured along the West line thereof, lying West of a line parallel to the West line of said quarter-quarter and 330.4 feet East thereof measured along the North line thereof and lying Westerly of new Highway 8, Ramsey County, Minn.