NE 10 2923

FROM THE OFFICE OF

CHARLES O. GEORGI COMPANY

2215 West County Road B — Saint Paul, Minnesota 55113

REGISTERED CIVIL ENGINEER AND LAND SURVEYOR

Certificate of Survey

I Hereby Certify that this plat shows a survey made by me of the property described on this plat, and that the corners are correctly placed as shown, and that all locations have been correctly shown.

Surveyed For Donald J. Rotier

Date November 1967

Scale 1" = 50'

By Charles O. Georgi
REGISTERED LAND SURVEYOR

Description:

The West 350 feet of that part of the South 1/2 of the North 1/2 of the South 1/2 of the SW 1/4 of the NE 1/4 of Section 10, T 29N, R 23W except the West 170 feet of the South 82 1/2 feet of said South 1/2 of North 1/2 of South 1/2 of SW 1/4 of NE 1/4 of Section 10, T 29N, R 23W, Ramsey County, Minn., Subject to Hamline Ave.

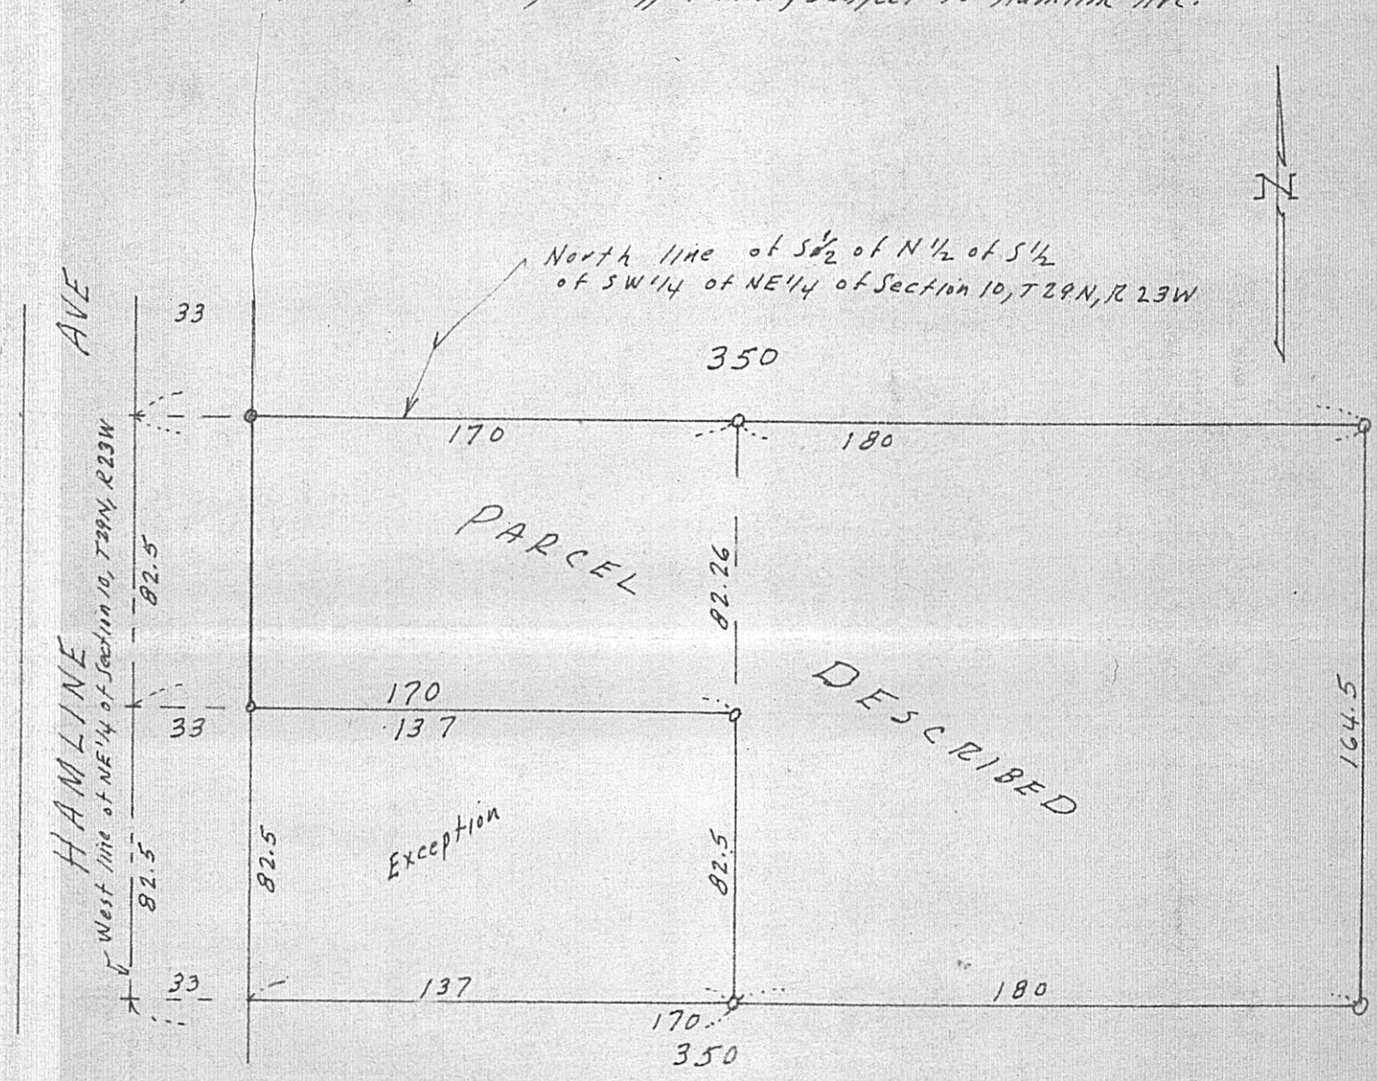

o Denotes Iron Monument.