SW 12 29 23

# Certificate of Survey

FROM THE OFFICE OF

## CHARLES O. GEORGI COMPANY

2215 West County Road B — Saint Paul, Minnesota 55113

REGISTERED CIVIL ENGINEER AND LAND SURVEYOR

*I Hereby Certify that* this plat shows a survey made by me of the property described on this plat, and that the corners are correctly placed as shown, and that all locations have been correctly shown.

*Surveyed For* James A. Westley

*Date* July 1967

*Scale* 1" = 100'

By Charles O. Georgi

REGISTERED LAND SURVEYOR

**Description:**

The North ½ of the East 2 Acres of the West ½ of the SW¼ of the NE¼ of the SW¼ of Section 12 T29N, R23W.
Ramsey County, Minn

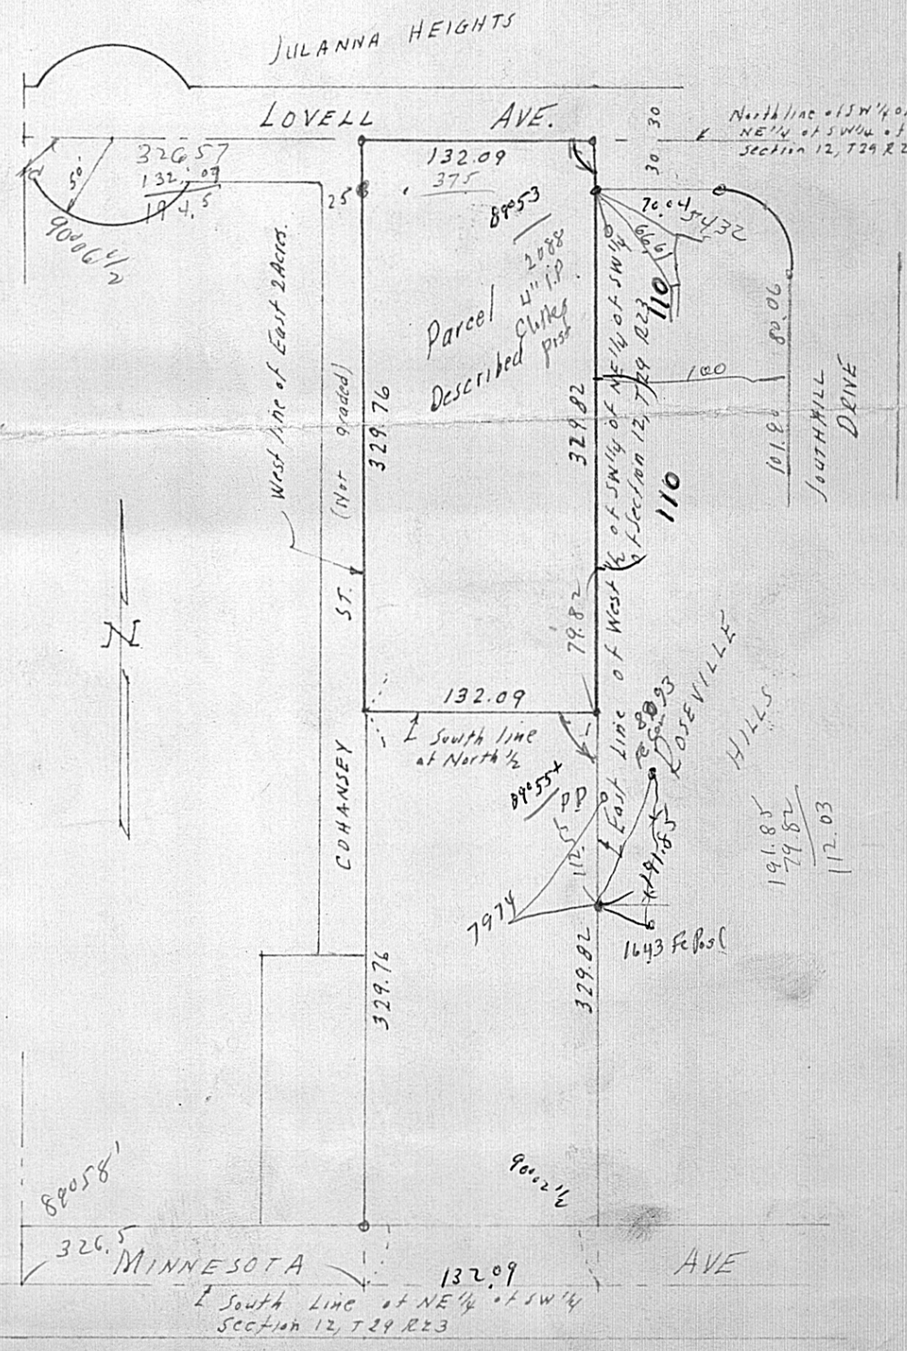


o Denotes Iron Pipe Monument
all corners to be reset or placed for this parcel.
12 July 1967