


~ PLAT OF SURVEY ~
Lot 3, Block 3, BAKEN ADDITION PLAT No 2
No 4374 Reiland Lane, Shoreview, Minn.

SCALE: 1" = 30'

T. J. Welch
Registered Surveyor
701 East 3rd St.
ST. PAUL, MINN. 55106
TEL. 776-0640
Oct. 2, 1967

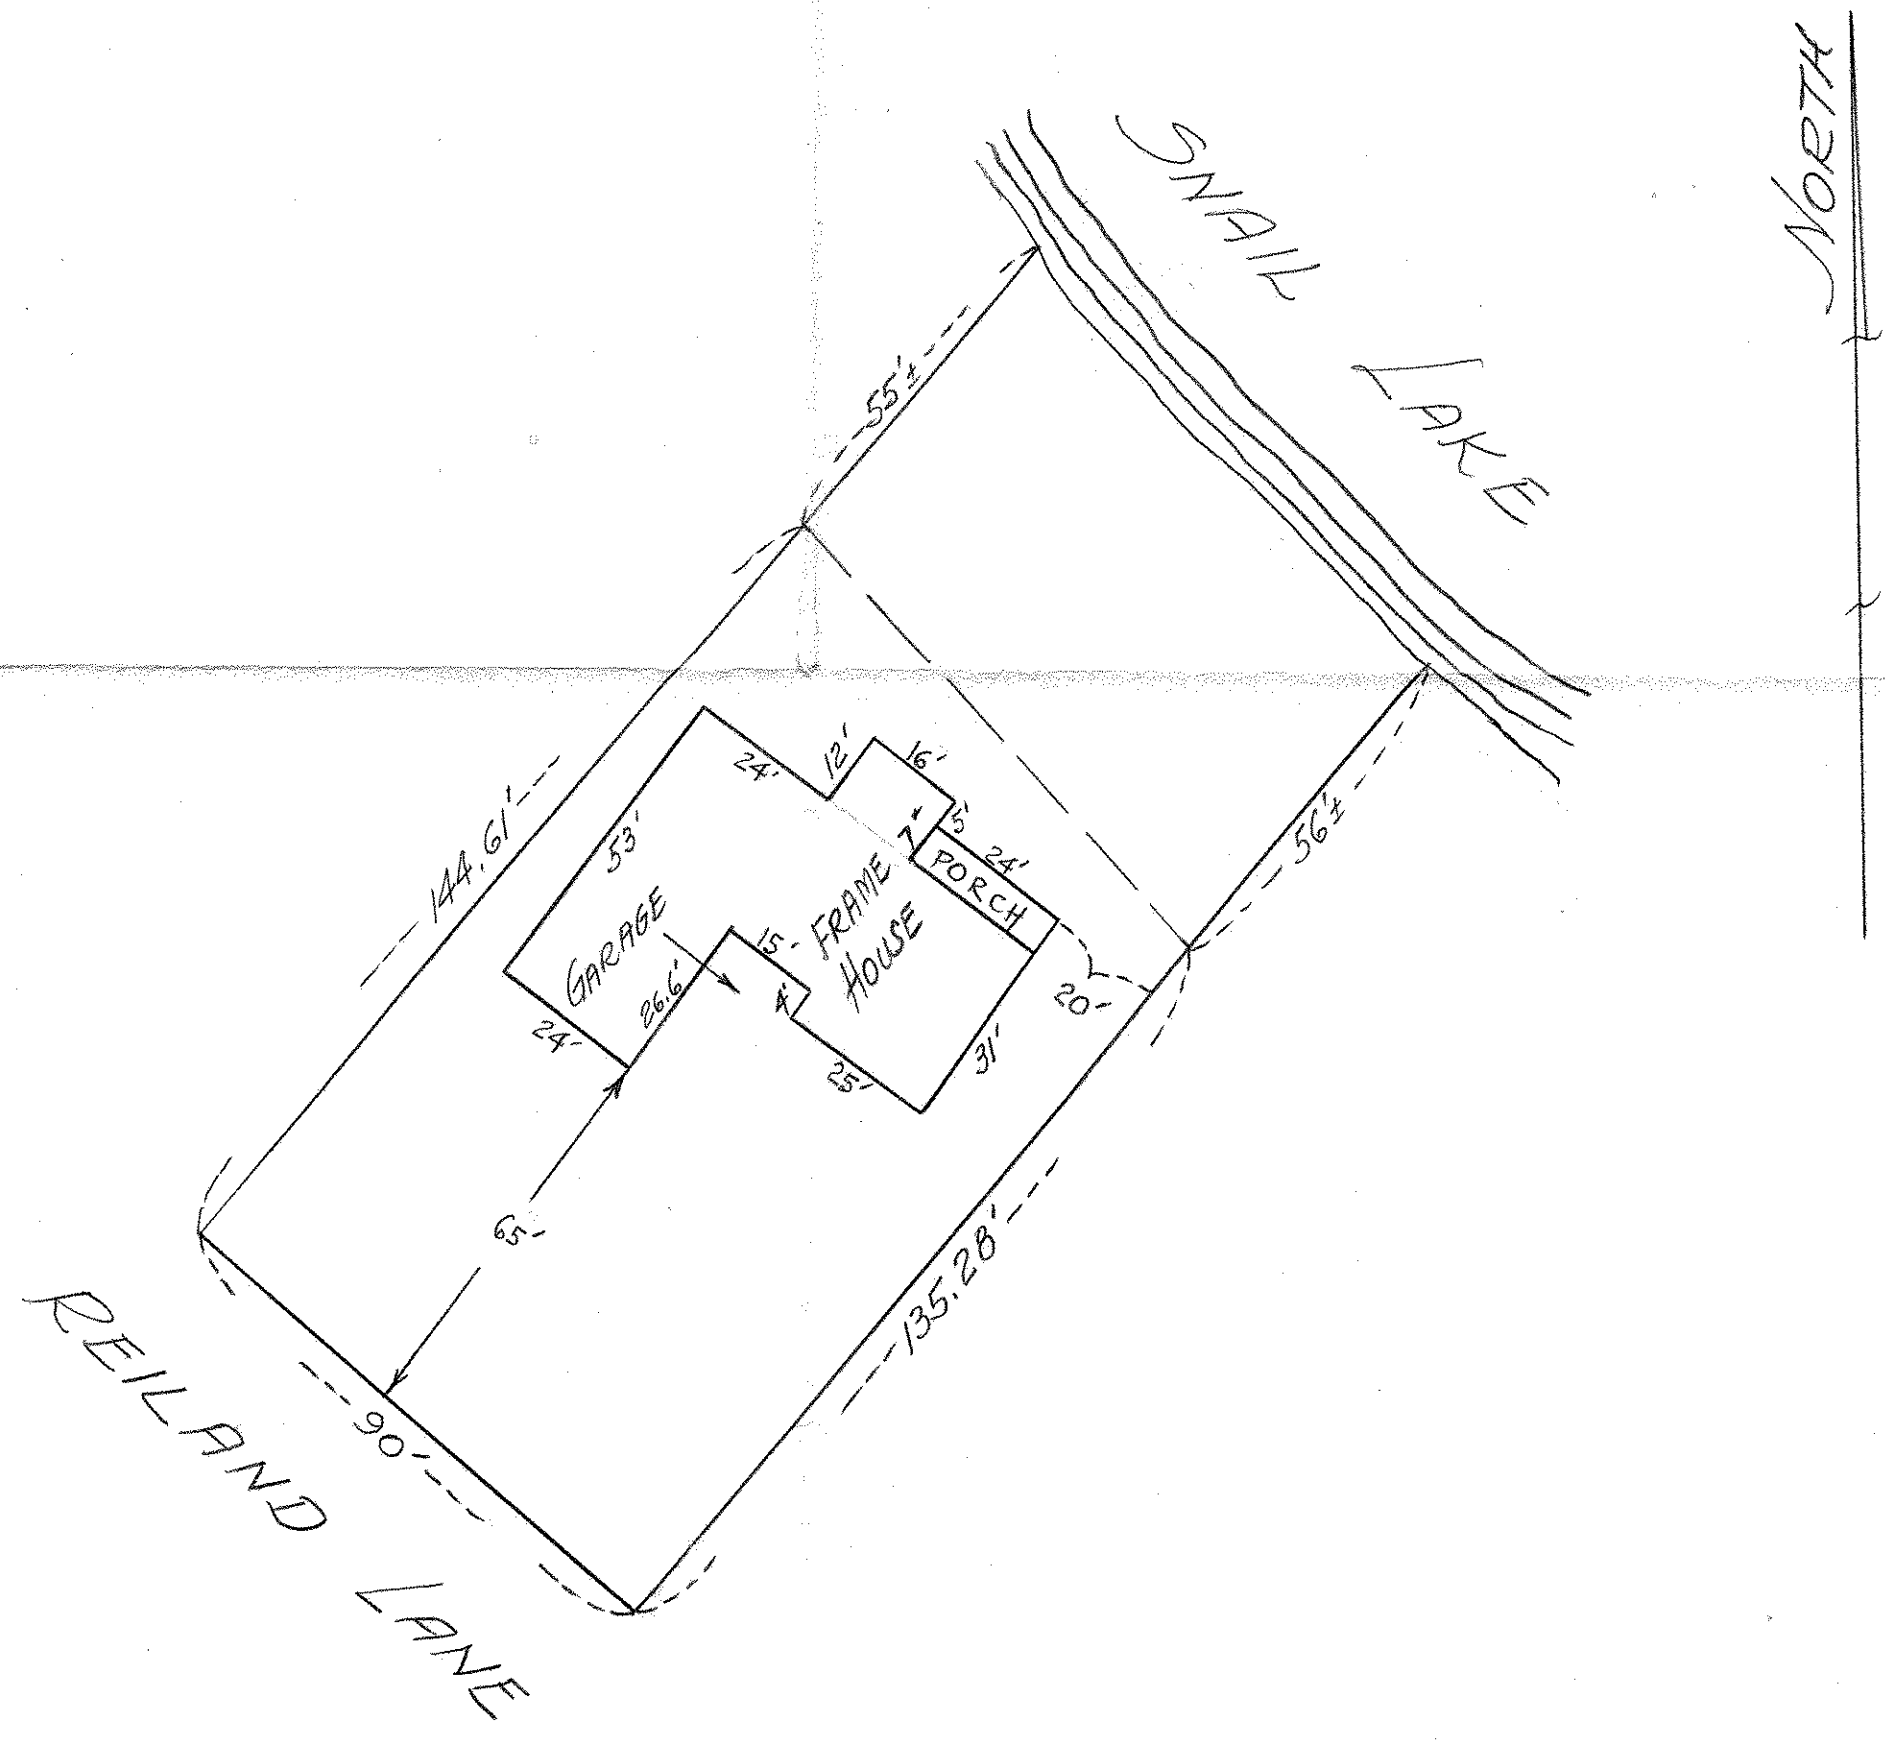

Mortgage Loan Survey only.