

SW 8 2922

FROM THE OFFICE OF

# CHARLES O. GEORGI COMPANY

2215 West County Road B

Saint Paul, Minnesota 55113

REGISTERED CIVIL ENGINEER AND LAND SURVEYOR

## Certificate of Survey

I Hereby Certify that this plat shows a survey made by me of the property described on this plat, and that the corners are correctly placed as shown, and that all locations have been correctly shown.

Surveyed For Patrick Cokley


Date September 1967

Scale 1" = 40'

By Charles O. Georgi  
REGISTERED LAND SURVEYOR


**Description:**

The North 70 feet of Lot 9,  
Block 4  
Sunrise Heights  
Ramsey County, Minn.

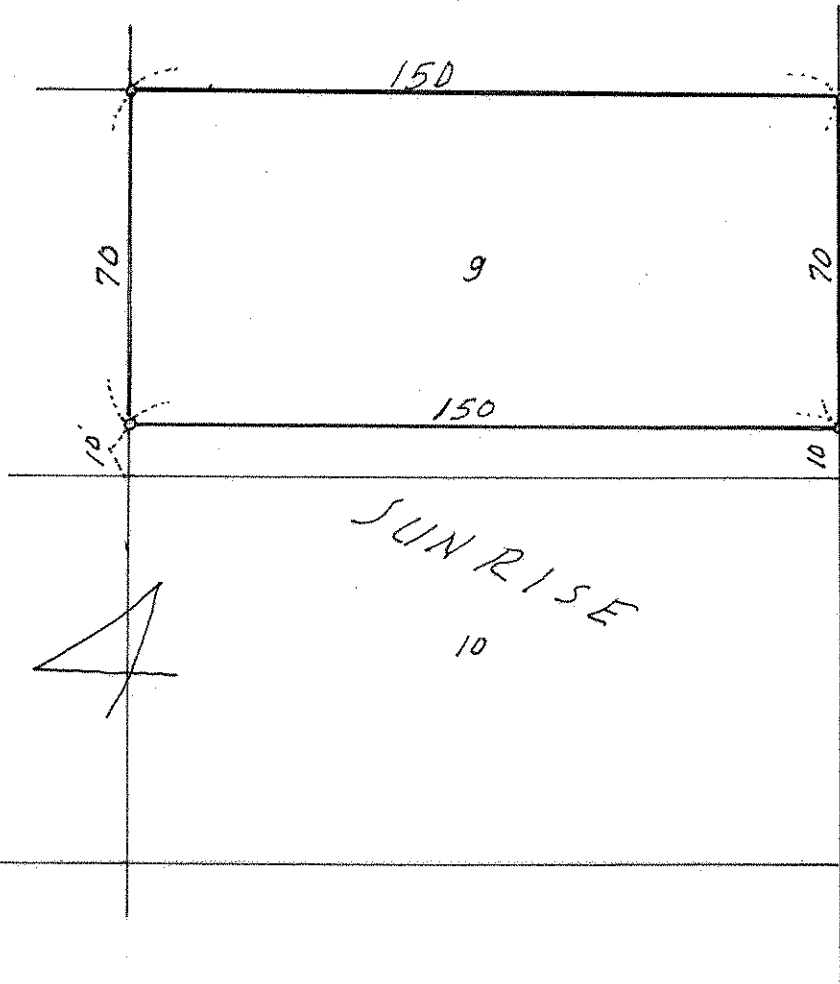

o Denotes Iron Pipe Monument

ST

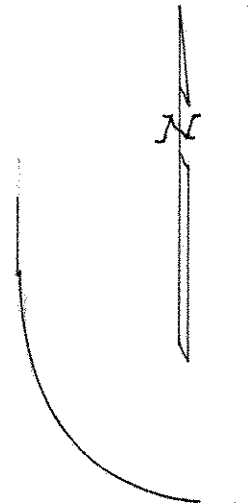

HENDRY  
PLACE  
60'

60' BURR

