

FROM THE OFFICE OF

CHARLES O. GEORGI COMPANY

2215 West County Road B

Saint Paul, Minnesota 55113

REGISTERED CIVIL ENGINEER AND LAND SURVEYOR

Certificate of Survey

I Hereby Certify that this plat shows a survey made by me of the property described on this plat, and that the corners are correctly placed as shown, and that all locations have been correctly shown.

Surveyed For Gary Buddy


Date Oct. 1967

Scale 1" = 30'

By Charles O. Georgi
REGISTERED LAND SURVEYOR

Description:

All of Lot 7 except
the West 8.74 feet thereof
and the West 18.74 feet of
Lot 8, Block 2,
Phalen View.

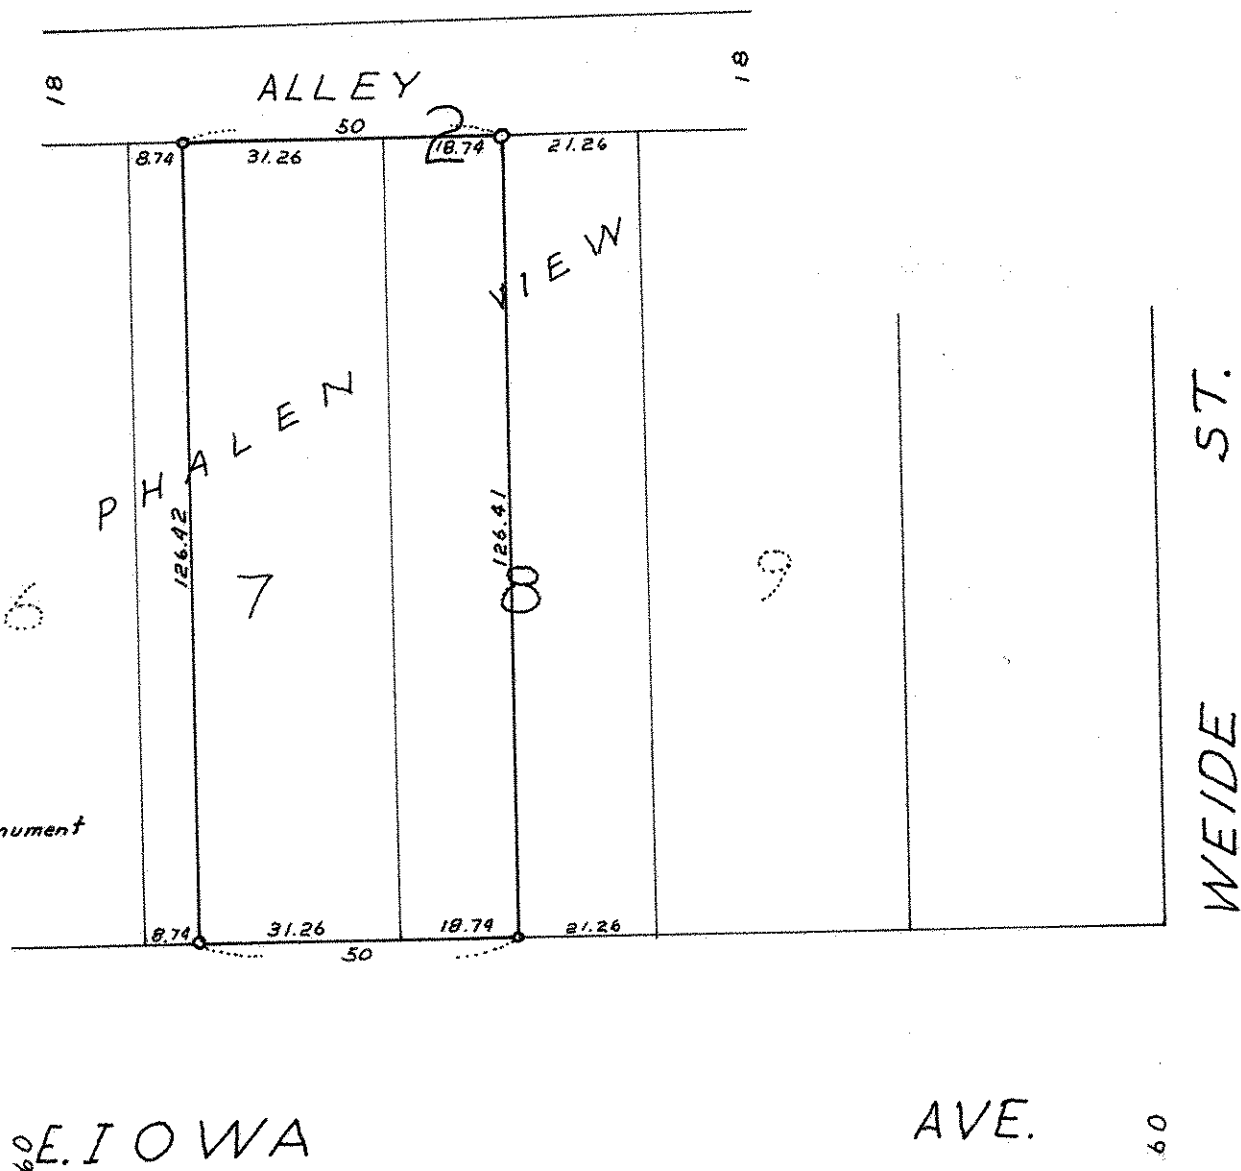

o denotes iron monument