SE 29 29 22

FROM THE OFFICE OF

CHARLES O. GEORGI COMPANY

2215 West County Road B — Saint Paul, Minnesota 55113

REGISTERED CIVIL ENGINEER AND LAND SURVEYOR

Certificate of Survey

I Hereby Certify that this plat shows a survey made by me of the property described on this plat, and that the corners are correctly placed as shown, and that all locations have been correctly shown.

Surveyed For Whirlpool Corp.

Date Sept 1967

Scale 1" = 50'

By Charles O. Georgi
REGISTERED LAND SURVEYOR

Description:

Lots 1,2,3,4,5,6,7, and 8, subject to widening of Arcade Street, and all of Lots 9 and 10; all in Charles Weide's Subdivision of the east half of Block 31 of Arlington Hills Addition.

Also that portion of the vacated east and west alley lying between the west line of Arcade Street and the west line of Lot 5, Charles Weide's Subdivision of the east half of Block 31 of Arlington Hills Addition, as extended northerly.

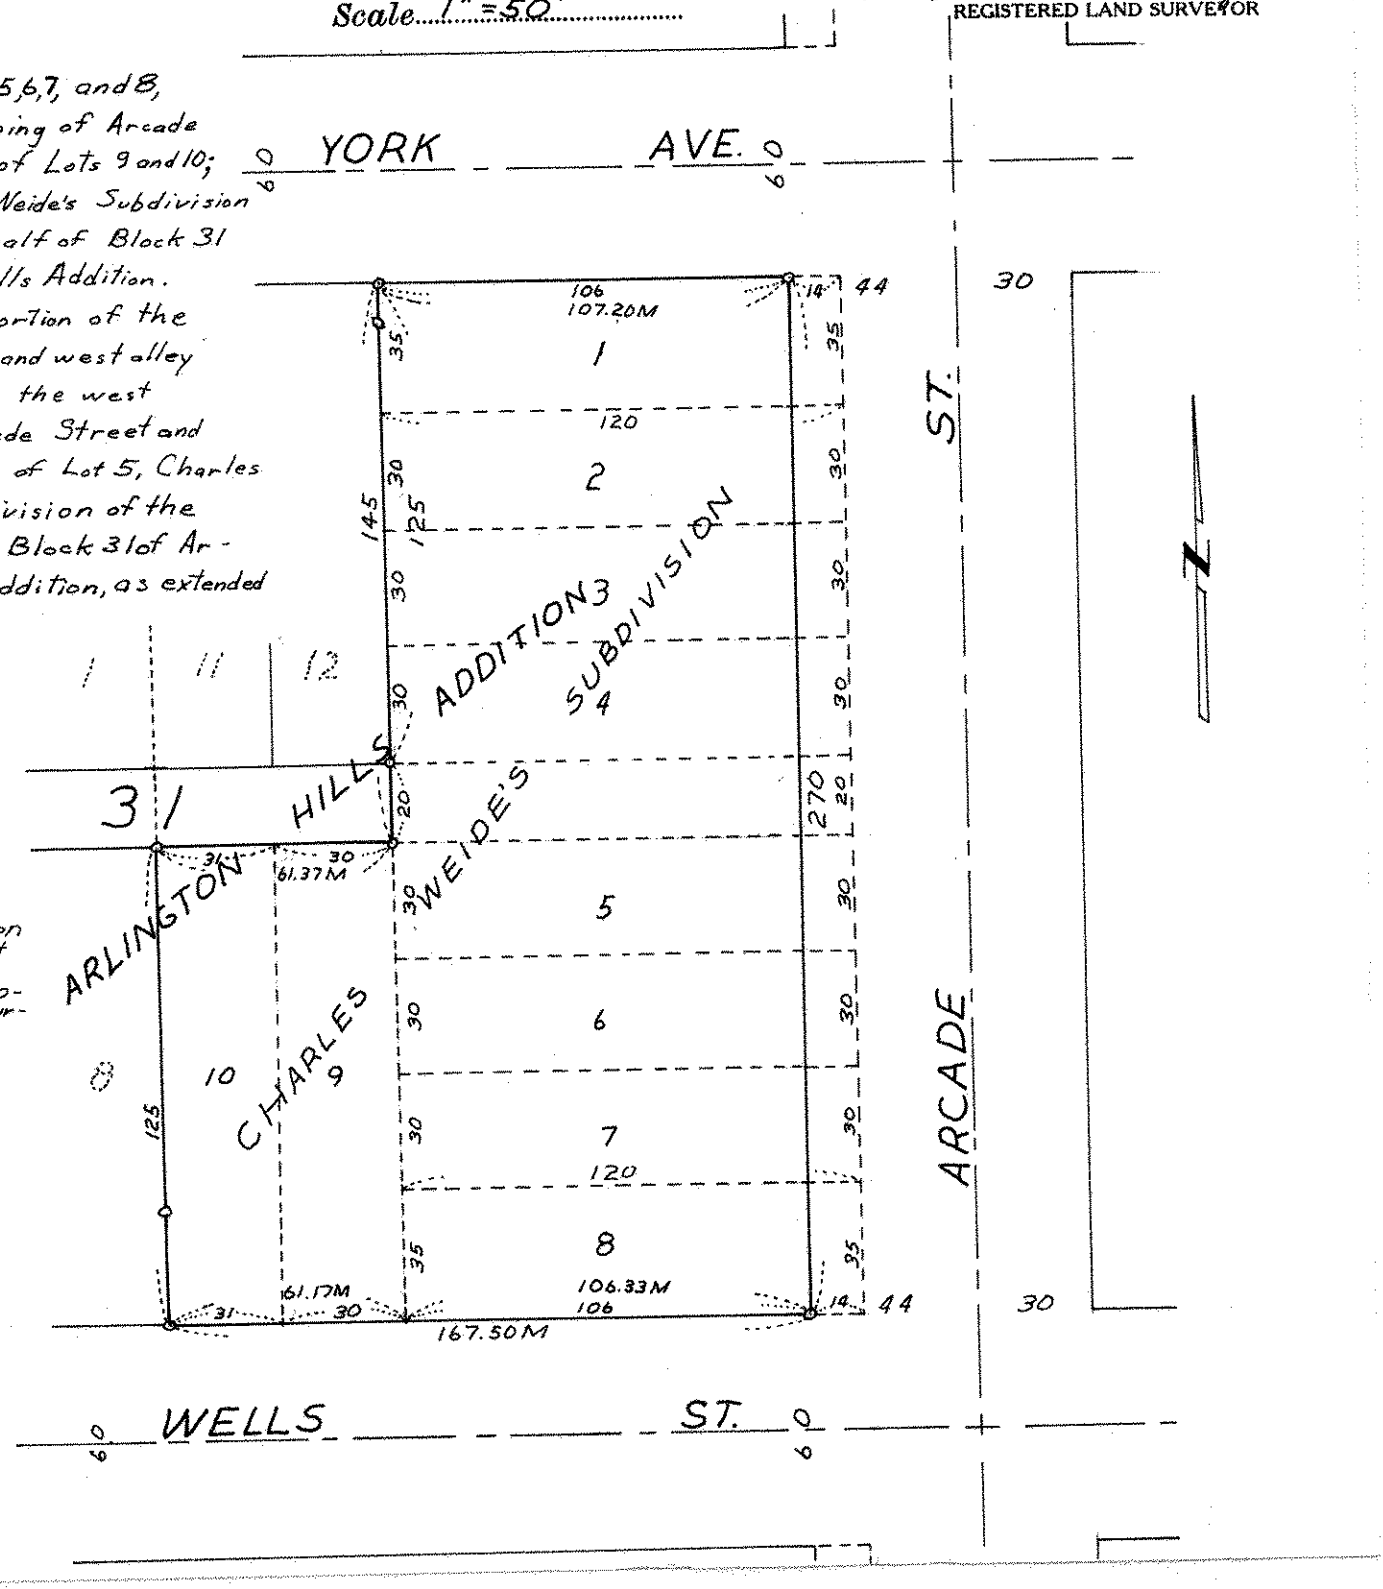

o denotes iron monument

M denotes prorated measurment