


PLAT OF SURVEY
 Lots 9-10-11-12 and 13, Block 9 Burlington Heights Division No. 1.

SCALE 1" = 40'

T. J. WELCH
 Registered Surveyor
 701 E. 3rd Street
 ST. PAUL, MINN. 55106
 TEL. 776-0640
 July 17, 1967

NORTH

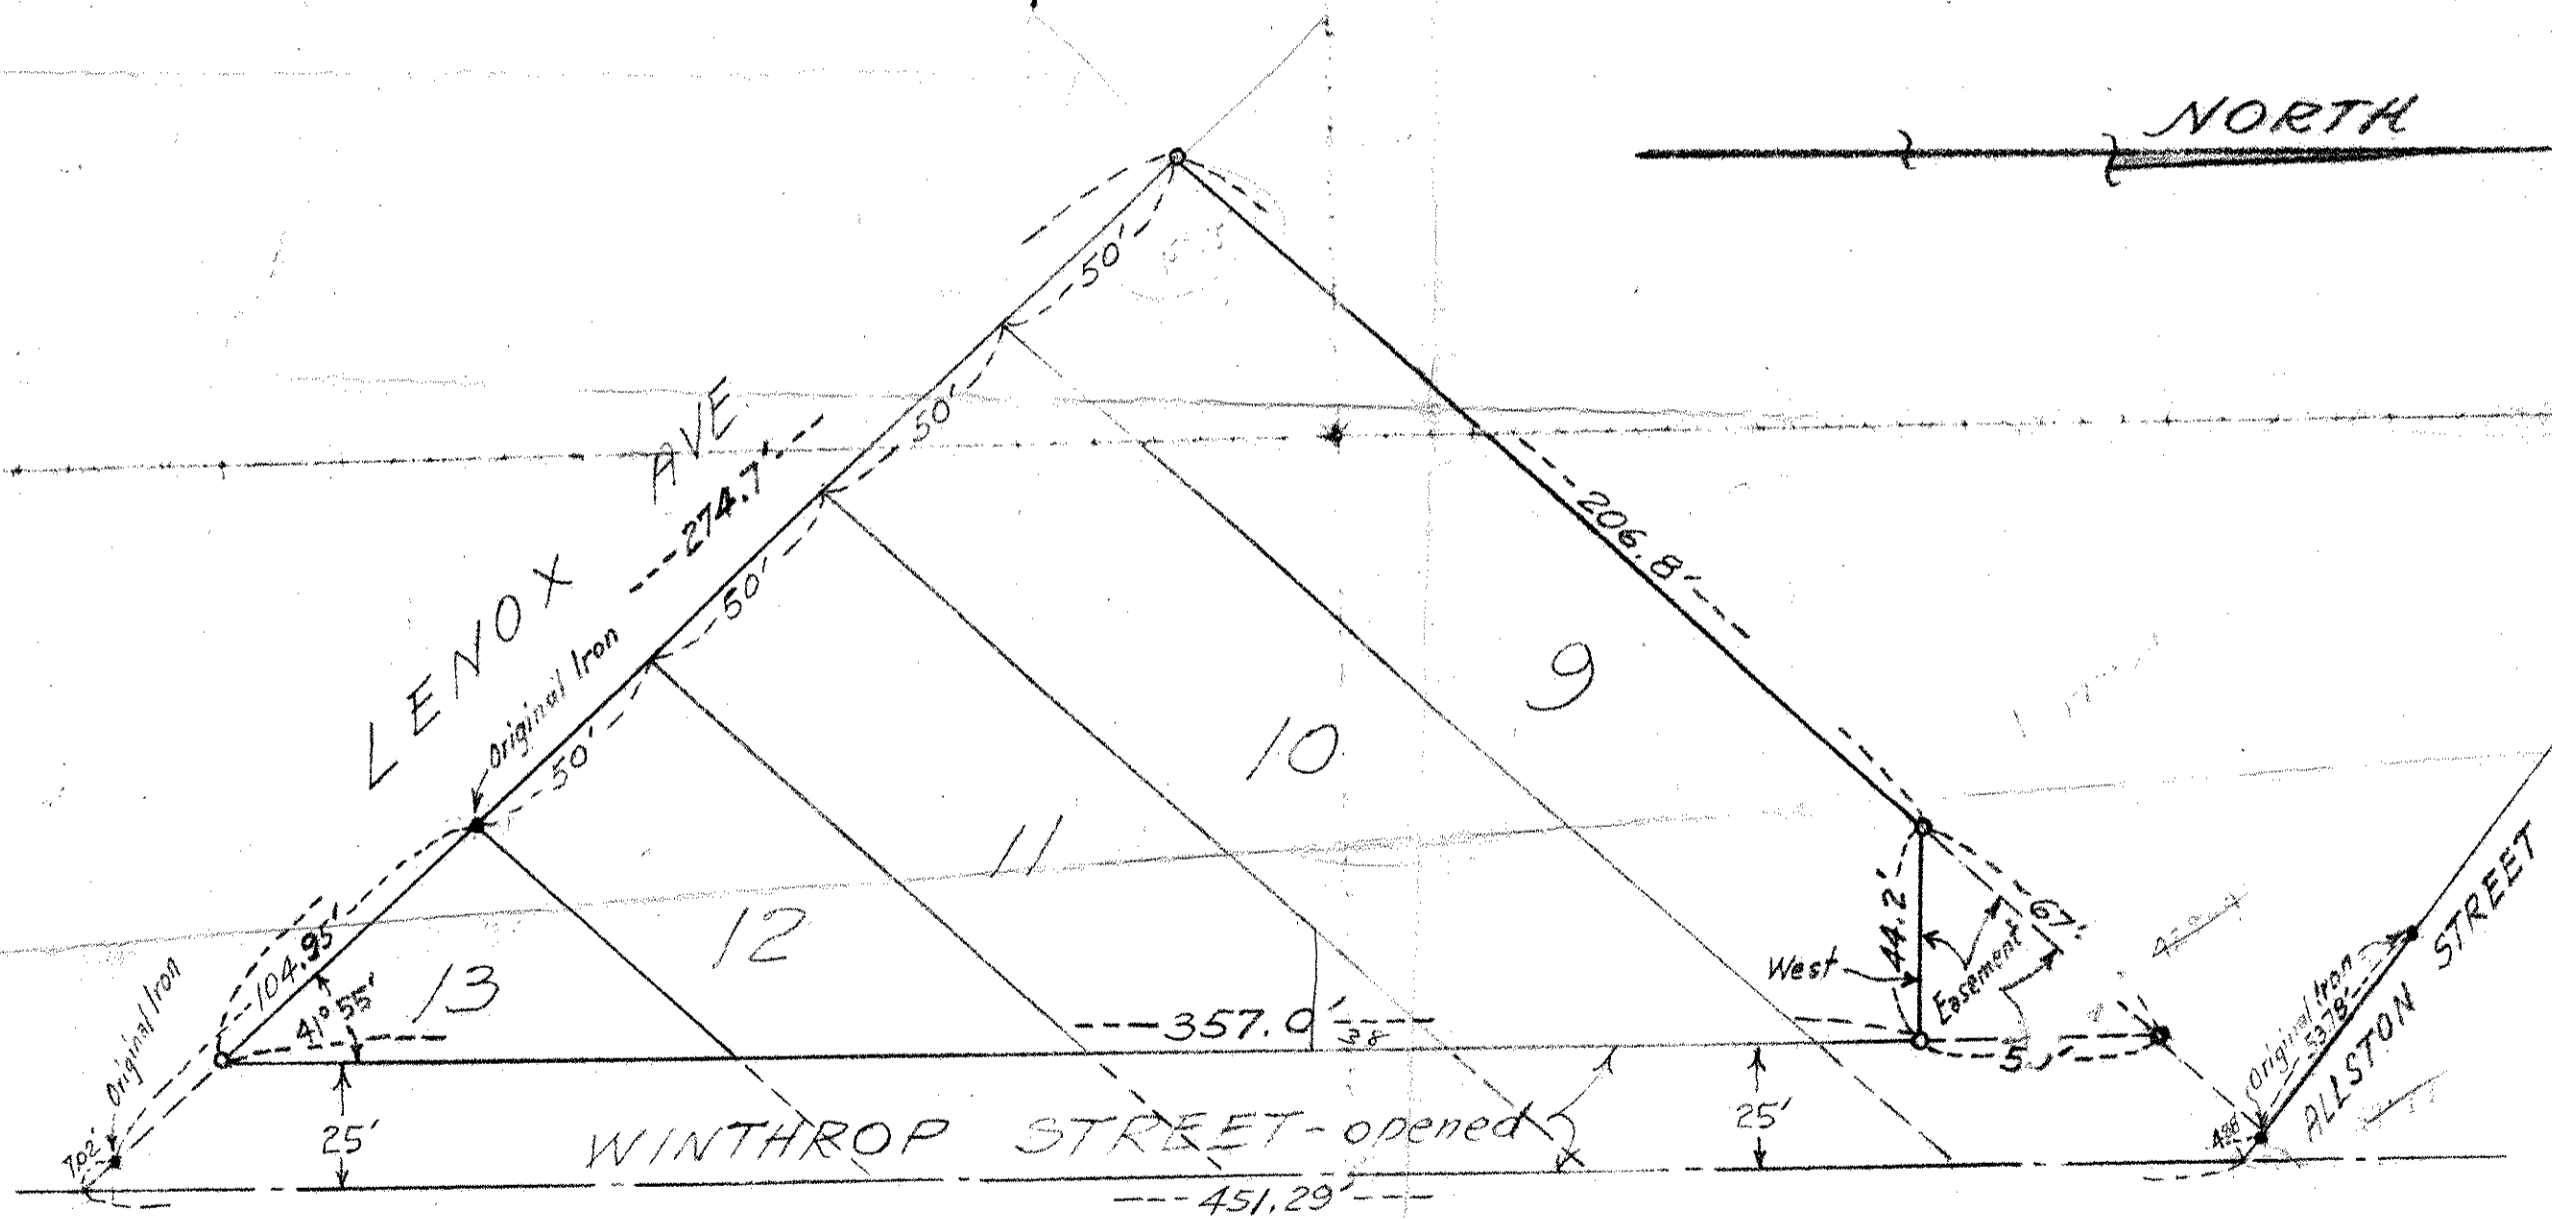

41 55
 98 11
 134 11.0
 125 65
 137 120
 42 110