NE 15 29 23

Certificate of Survey

FROM THE OFFICE OF

CHARLES O. GEORGI COMPANY

2215 West County Road B — Saint Paul, Minnesota 55113

REGISTERED CIVIL ENGINEER AND LAND SURVEYOR

I Hereby Certify that this plat shows a survey made by me of the property described on this plat, and that the corners are correctly placed as shown, and that all locations have been correctly shown.

Surveyed For Roseville Lutheran Church

Date June 1968

Scale 1" = 100'

By Charles O. Georgi
REGISTERED LAND SURVEYOR

Description:

Overall description being prepared by St. Paul Abstract to consolidate the many individual parcels and correct any variations. It is recommended that your attorney review these descriptions.

Description: - To Village of Roseville for widening Fernwood Ave.:

The West 15 feet of the SW 1/4 of the SE 1/4 of the NE 1/4 of Section 15, T29N, R23W. except the North 220 feet thereof. Subject to Roselawn Ave.

Note: The North 220 feet was previously deeded for widening Fernwood Ave 15 feet.

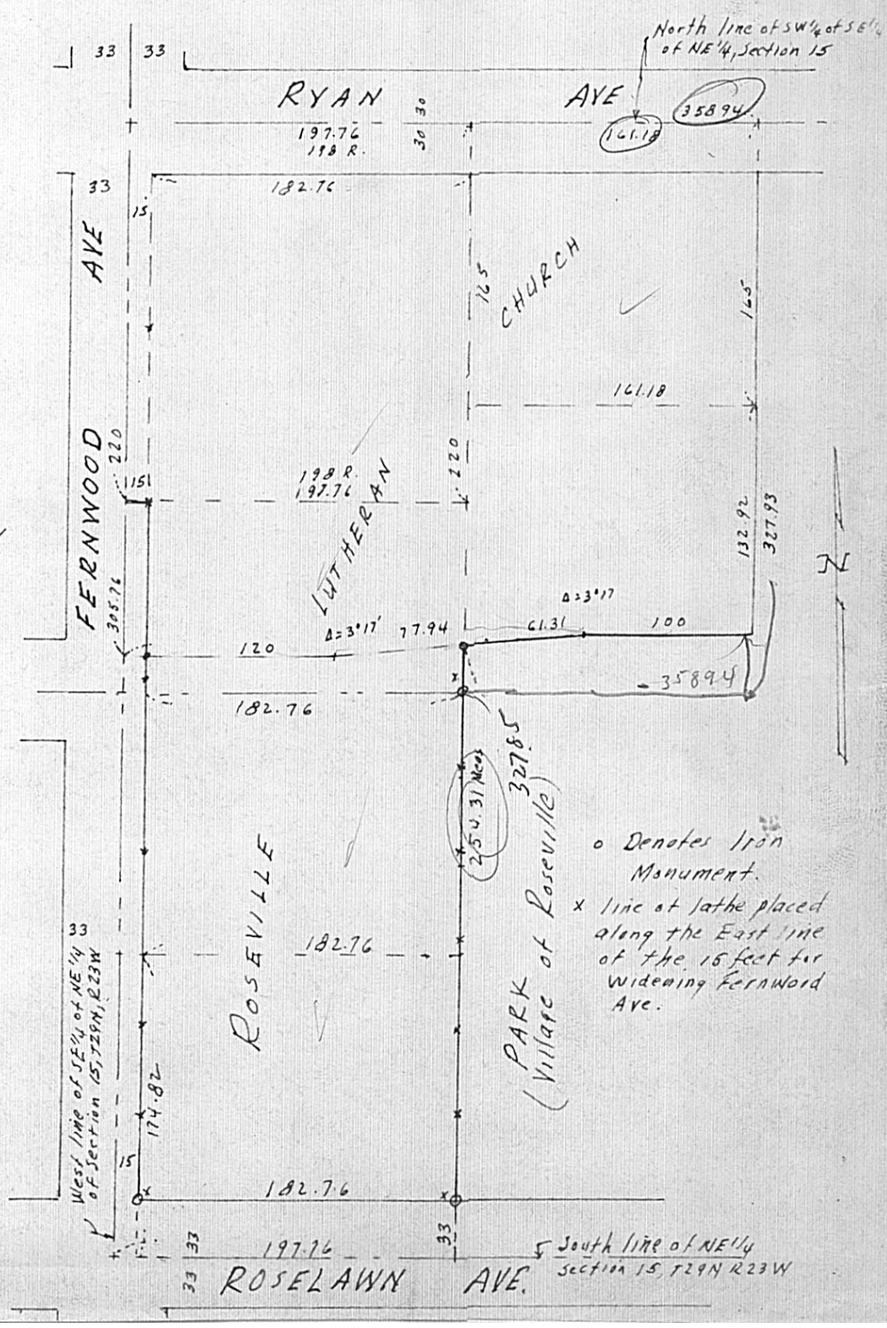

o Denotes Iron Monument.

x line of lathe placed along the East line of the 15 feet for widening Fernwood Ave.