FROM THE OFFICE OF

Gertificate
of Survey

CHARLES O. GEORGI COMPANY

2215 West County Road B

Saint Paul, Minnesota 55113

REGISTERED CIVIL ENGINEER AND LAND SURVEYOR

I Hereby Certify that this plat shows a survey made by me of the property described on this plat, and that the corners are correctly placed as shown, and that all locations have been correctly shown.

Surveyed For George A Peterson


Date September 1968

Scale /"= 40'

Charles O. Longi

Description:

Lot 7 Block 1 Howland Homesites Ramsey County, Minn

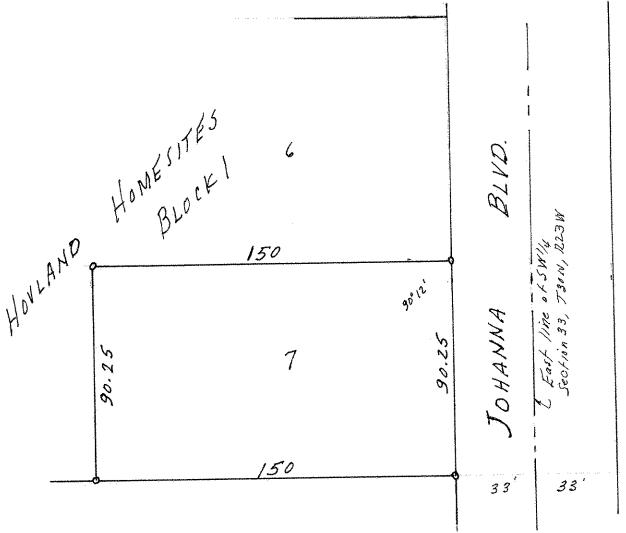

o Denotes Iron Monument.