NE 17 29 22

FROM THE OFFICE OF

CHARLES O. GEORGI COMPANY

2215 West County Road B — Saint Paul 8, Minnesota

REGISTERED CIVIL ENGINEER AND LAND SURVEYOR

Certificate of Survey

I Hereby Certify that this plat shows a building location survey made by me on the property described on this plat, and that all locations, have been correctly shown.

Date May 1968 — File

Scale 1" = 30' — By Charles O. Georgi
REGISTERED LAND SURVEYOR

For: Mrs. Wloschin
Placed Iron Monuments at corners as shown on July 24, 1968 and they are correct
Charles O. Georgi

Ban Con Inc.

Description:
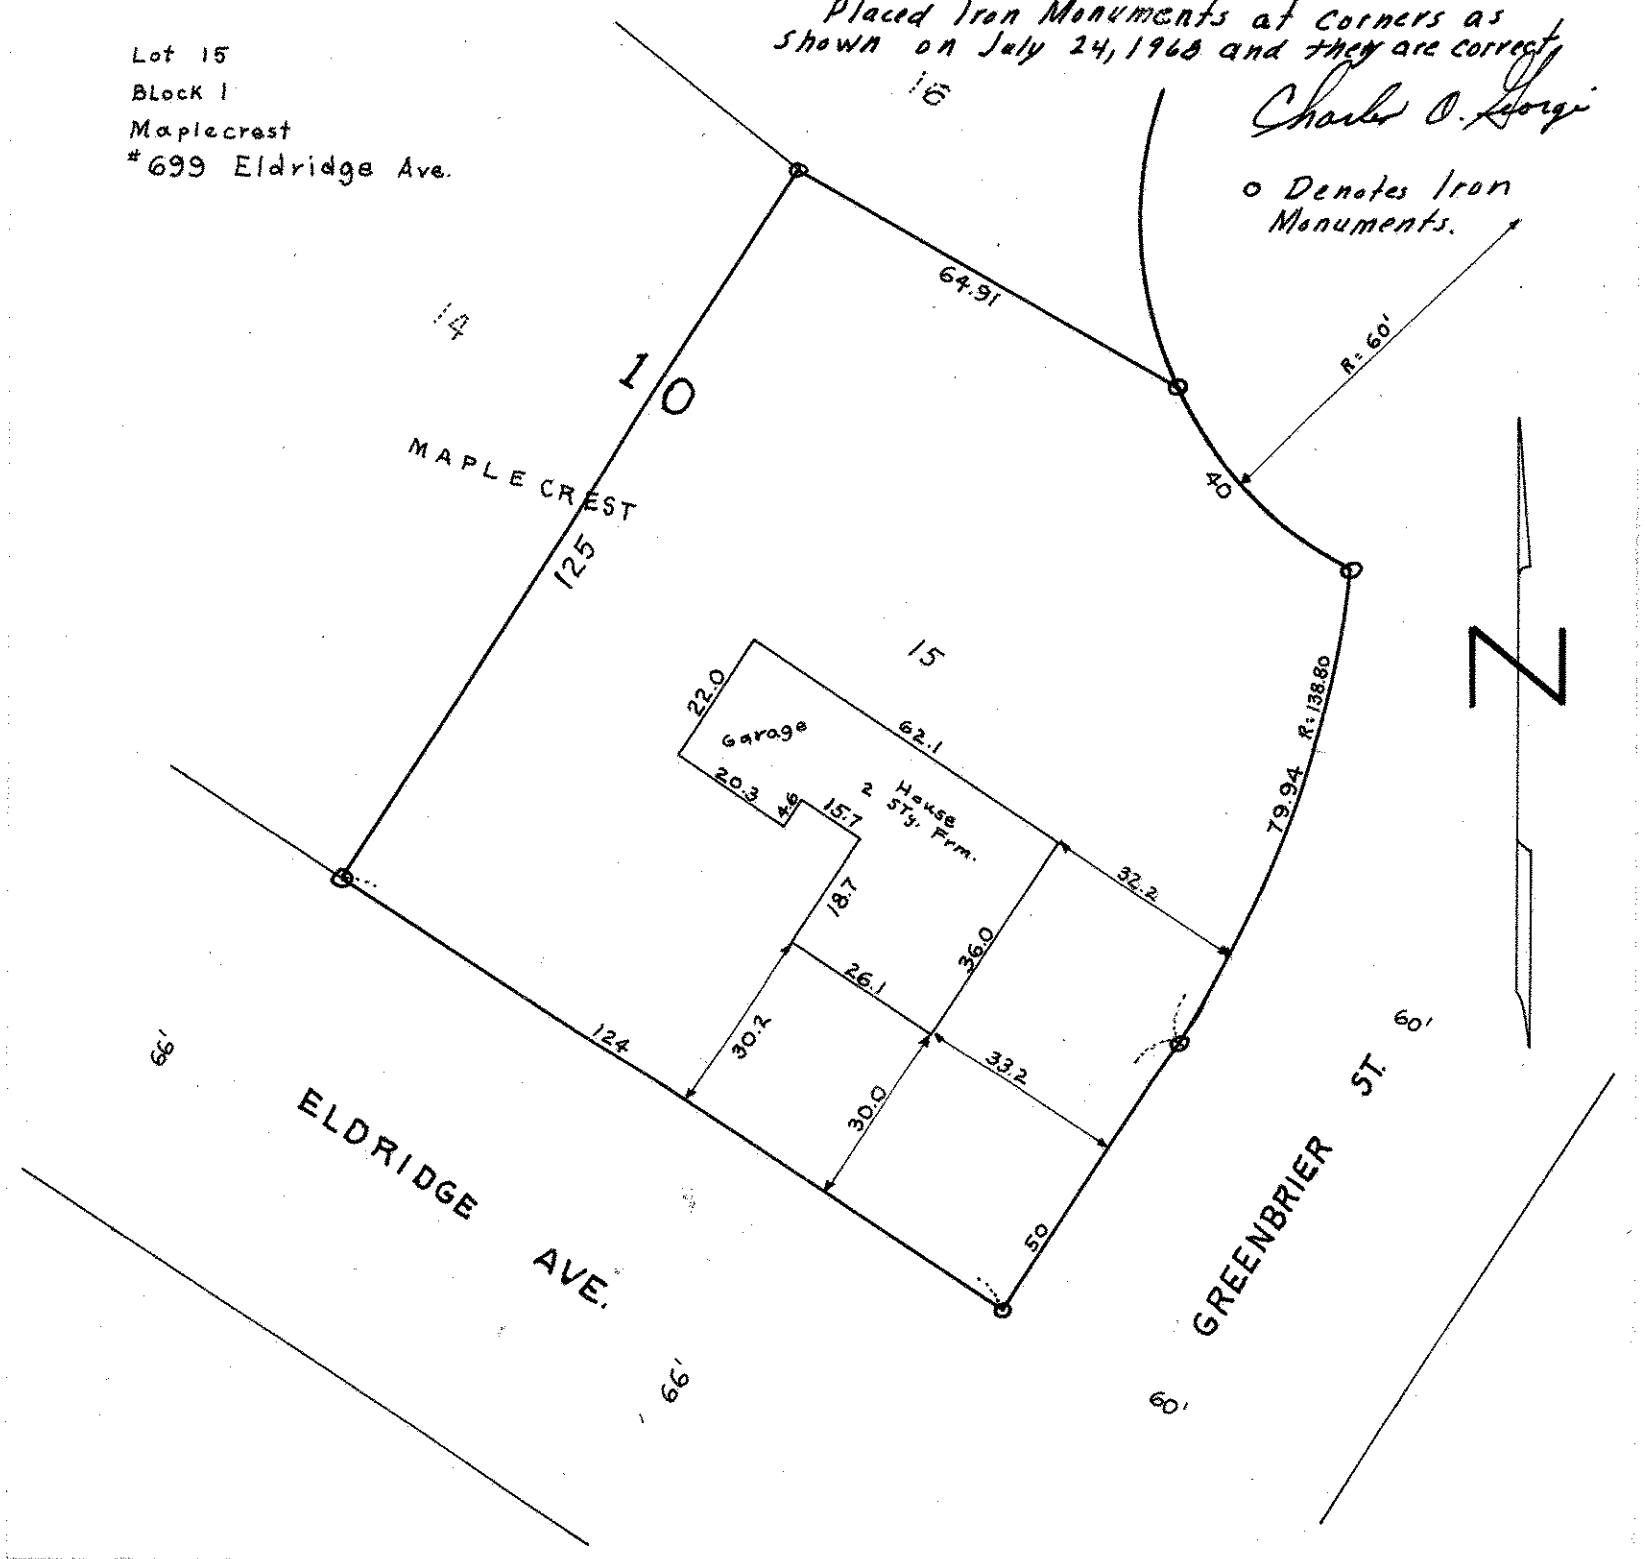
Lot 15
Block 1
Maplecrest
#699 Eldridge Ave.