NW 7 29 22

FROM THE OFFICE OF

CHARLES O. GEORGI COMPANY

2215 West County Road B Saint Paul, Minnesota 55113

REGISTERED CIVIL ENGINEER AND LAND SURVEYOR

Certificate of Survey

I Hereby Certify that this plat shows a survey made by me of the property described on this plat, and that the corners are correctly placed as shown, and that all locations have been correctly shown.

Surveyed For SPEEDY MARKETS Inc.

Date July 1968

Scale 1" = 50'

By Charles O. Georgi
REGISTERED LAND SURVEYOR

Description:

Lots 23, 24, 25, 26, 27, 28 and 29
Block 6,
North Heights
Ramsey County, Minn.

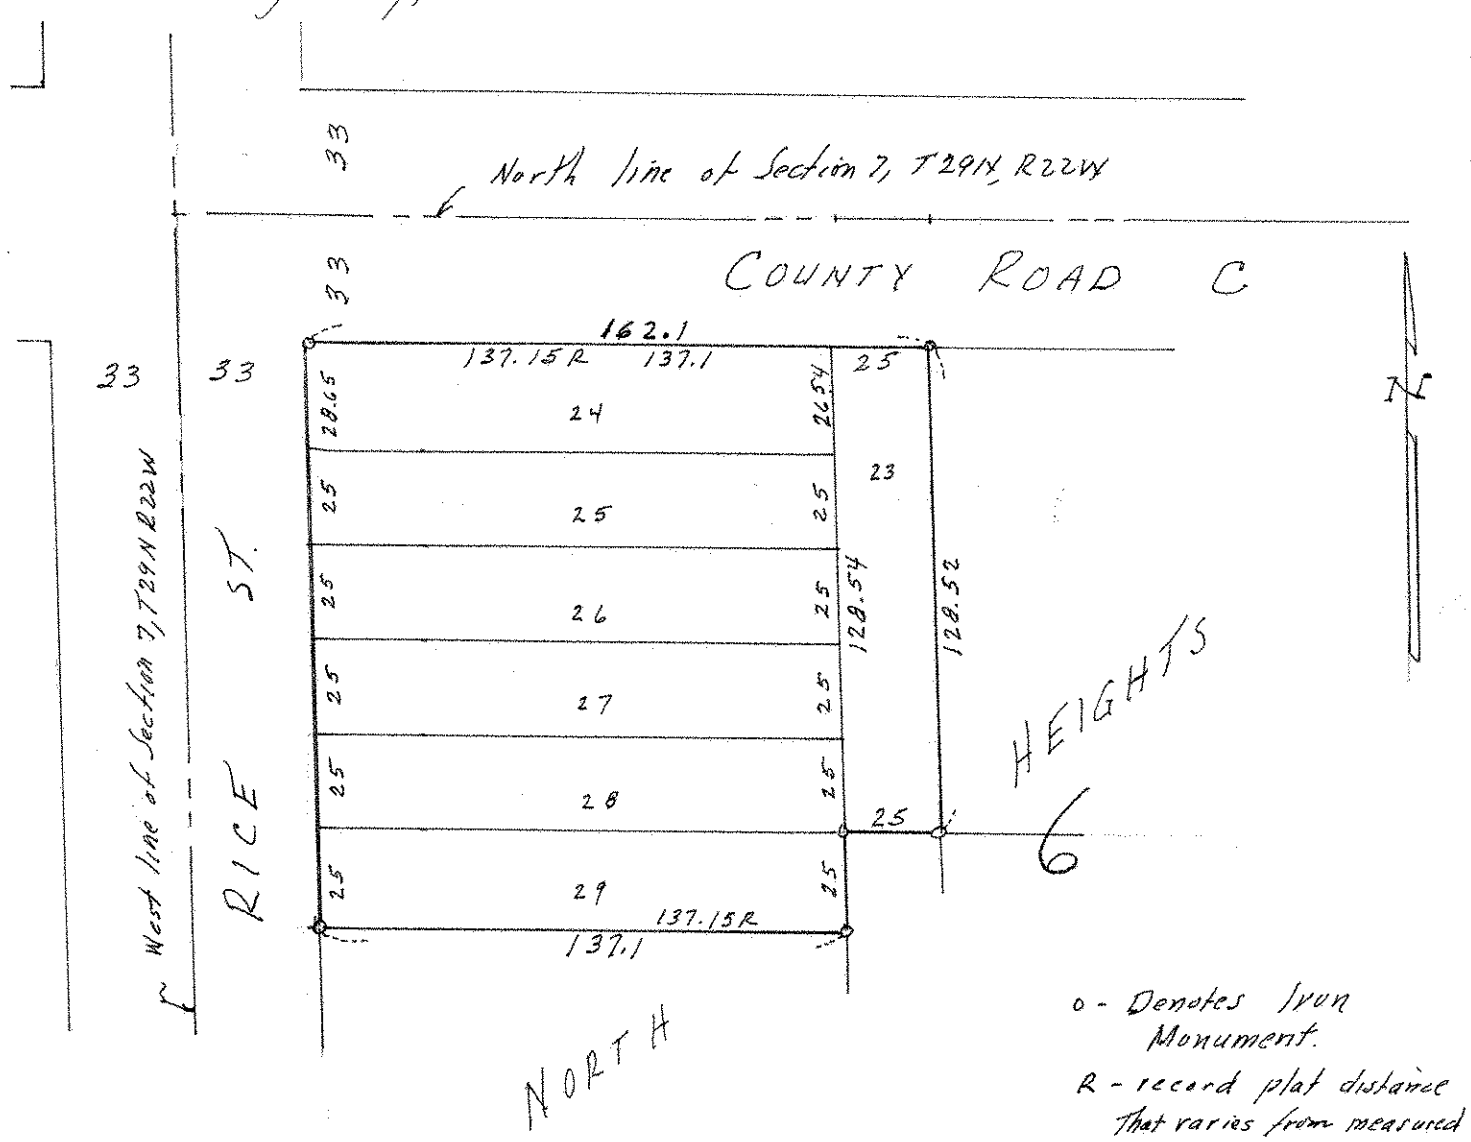

o - Denotes Iron Monument.

R - record plat distance that varies from measured distance.