SE 18

Certificate of Survey

FROM THE OFFICE OF

CHARLES O. GEORGI COMPANY

2215 West County Road B Saint Paul, Minnesota 55113

REGISTERED CIVIL ENGINEER AND LAND SURVEYOR

I Hereby Certify that this plat shows a survey made by me of the property described on this plat, and that the corners are correctly placed as shown, and that all locations have been correctly shown.

Surveyed For William Fagan

Date Sept. 1968

Scale 1" = 100'

By Charles O. Georgi
REGISTERED LAND SURVEYOR

Description:

The South 8 rods (132 feet) of the NE¼ of the SE¼ of the SE¼ of Section 18 T29N, R22W except the East 183 feet thereof, lying Easterly of Trunk Highway No 390 - 35 E

Highway Taking - All that part which lies Wly of a line run parallel with and distant 280 feet Easterly of the following described line: Beginning at a point on the South line of said Section 18 distant 740.2 feet Wly of the SE Corner thereof, thence run Northerly at an angle of 92°14' with said South Section line (measured from East to North) for 1100 feet and there terminating.

together with all that part of the above described tract adjoining and Easterly of the above described strip which lies Wly of the following described line: beginning at a point on the South line of the above described tract distant 60 feet Ely of its intersection with the Ely boundary of the above described strip, thence run Northerly to a point on the North line of the South 4 rods (66 feet) of the North 24 rods (396 feet) of the NE¼ of SE¼ of SE¼ of said Section 18 distant 240 feet Ely of the NWly Corner of said South 4 rods (66 feet) and there terminating
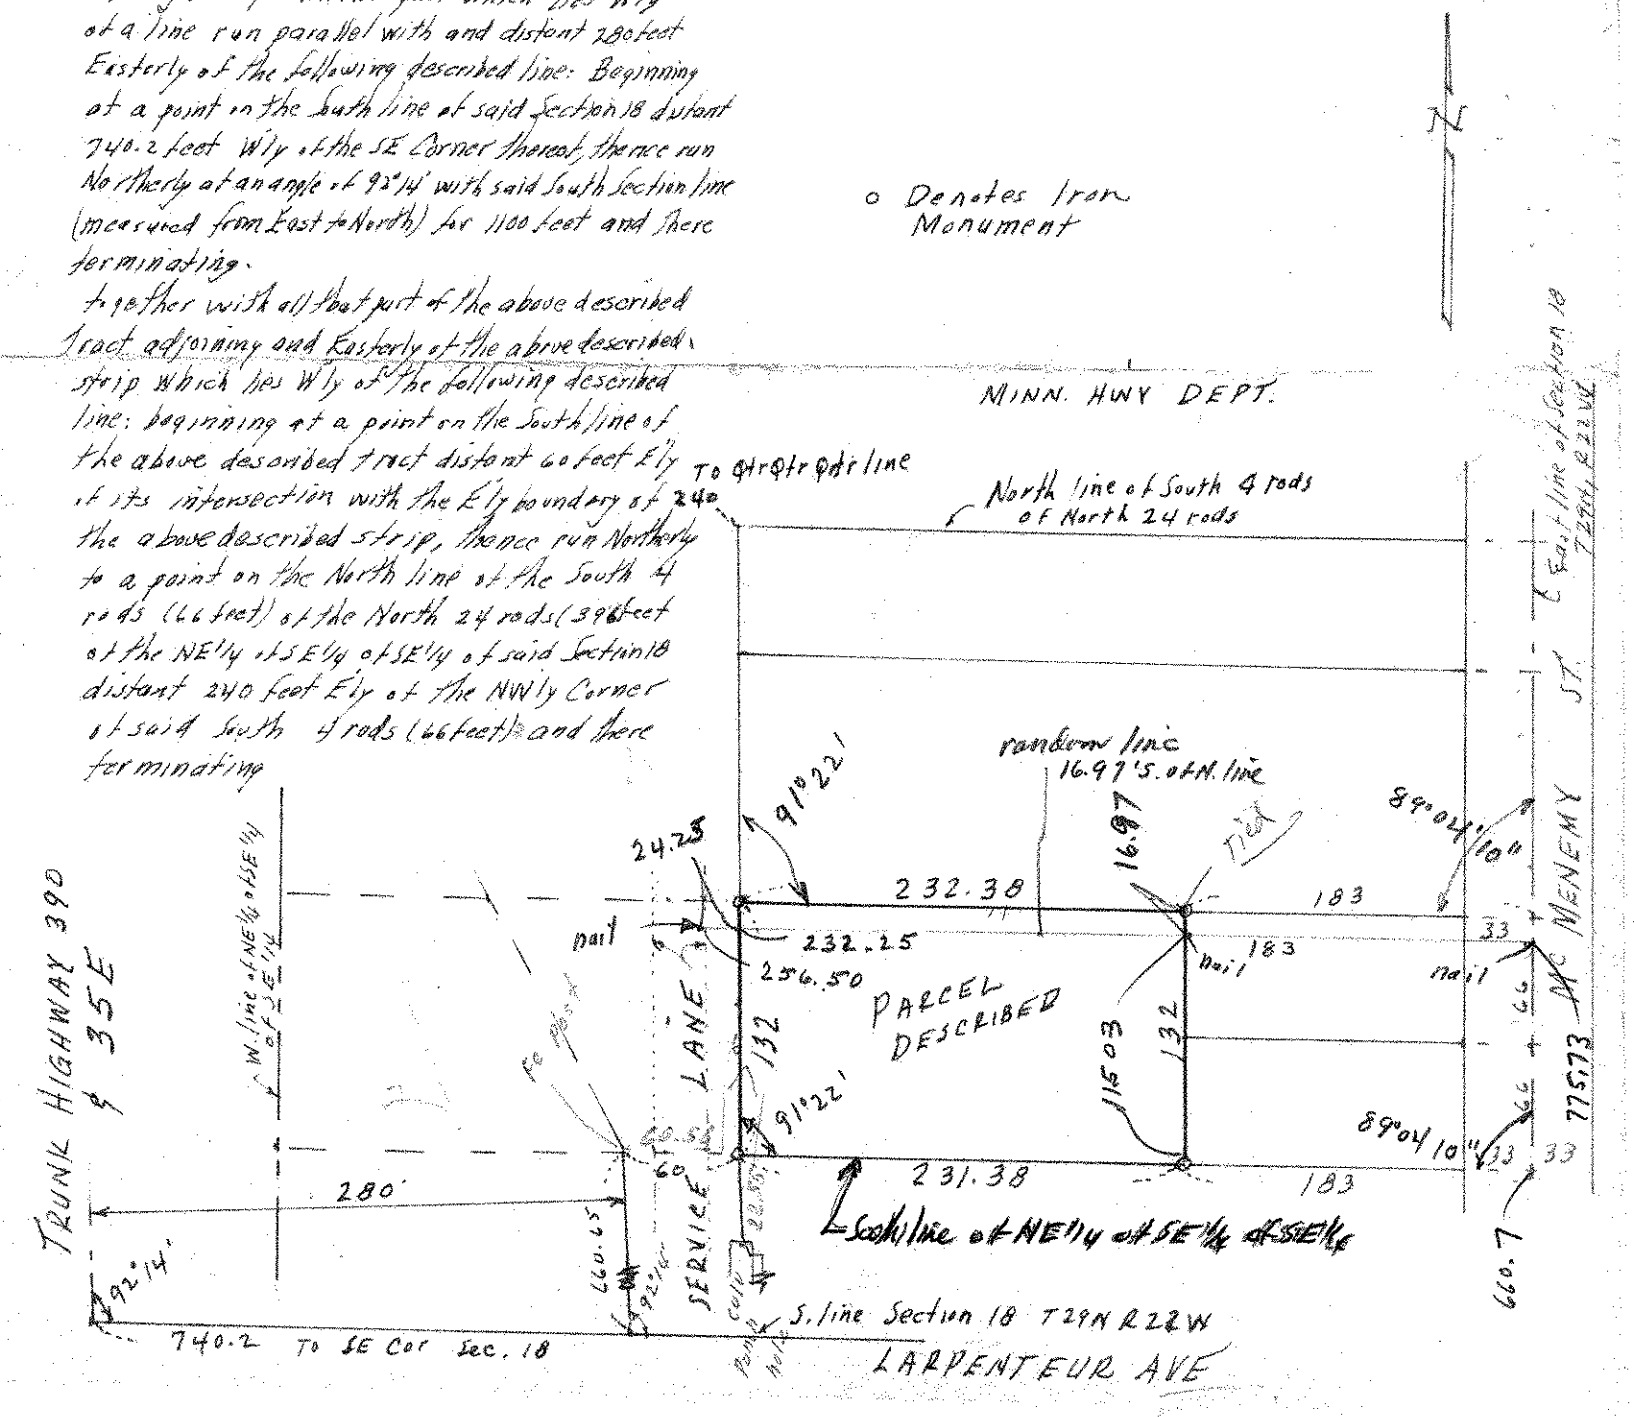
o Denotes Iron Monument