

CERTIFICATE OF SURVEY

MILNER W. CARLEY & ASSOCIATES

CONSULTING CIVIL ENGINEERS LAND SURVEYORS

500 W. HWY. 96^{1/2}
ST. PAUL 12, MINN.
484-3301


314 OAK ST.
SAUK CENTRE, MINN.
352-3664

18 4TH AVE. S.E.
ST. CLOUD, MINN.
251-7751

I hereby certify that this survey, plan, or report was prepared by me or under my direct supervision and that I am a duly Registered Land Surveyor under the laws of the State of Minnesota.

Thomas S. Bergquist

Reg. No. 7725 Date May 4, 1968

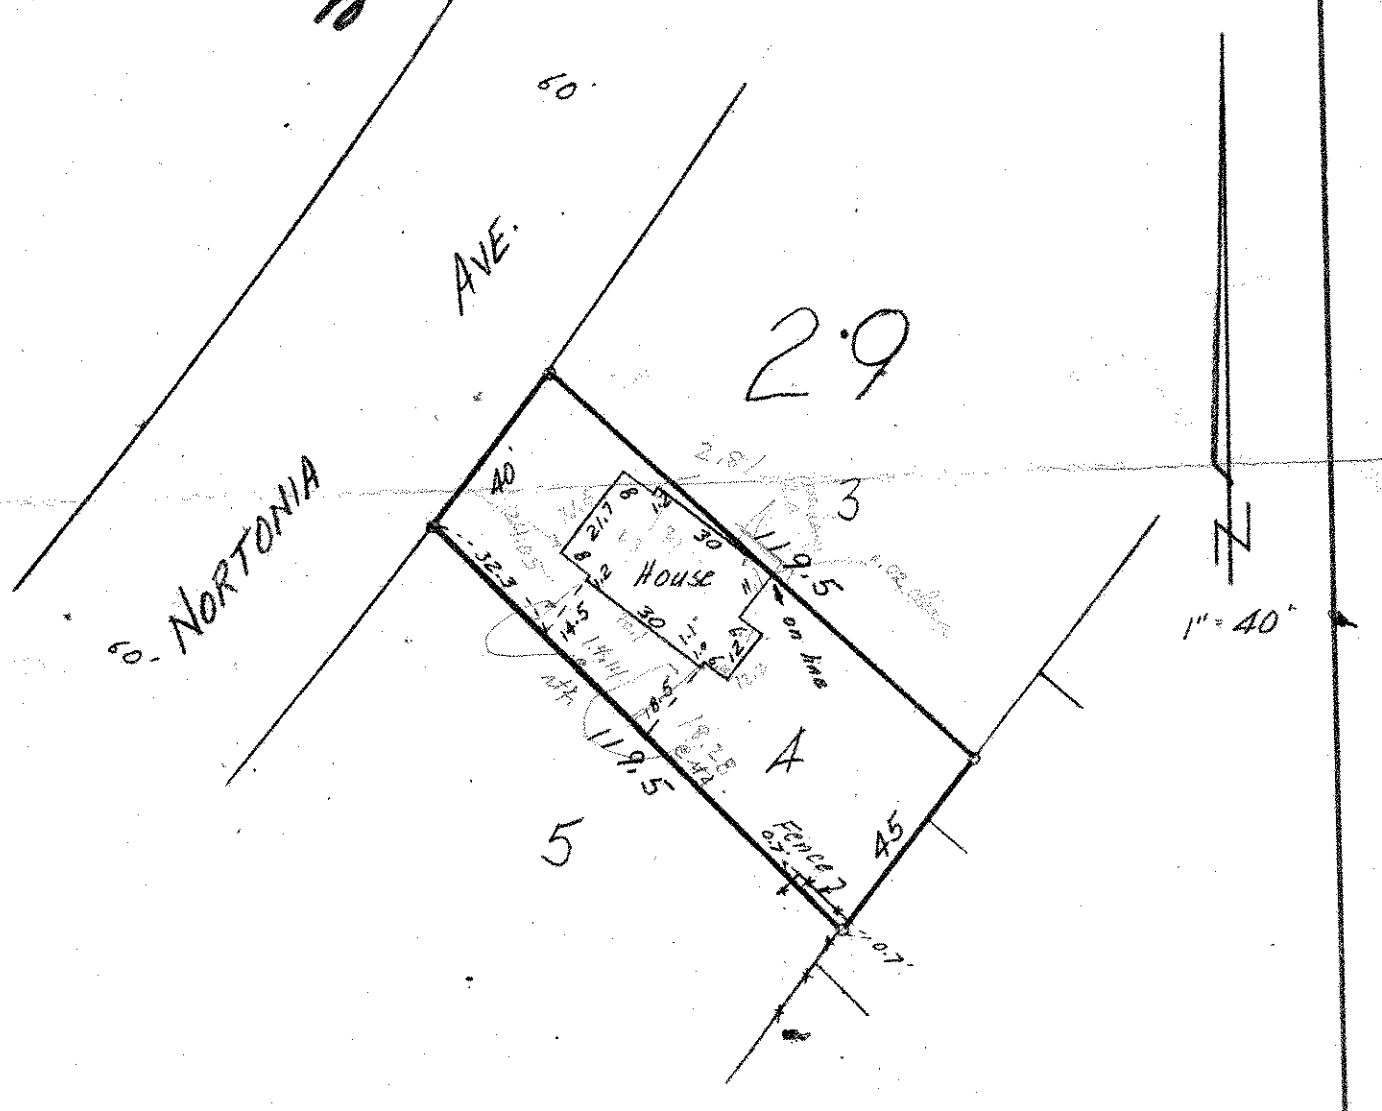

Lot 4, Block 29, BEAVER LAKE HEIGHTS
Ramsey County, Minn.

68-156
356-39

L-3050