FROM THE OFFICE OF

Certificate at Survey

CHARLES O. GEORGI COMPANY

2215 West County Road B

Saint Paul, Minnesota 55113

REGISTERED CIVIL ENGINEER AND LAND SURVEYOR

I Hereby Certify that this plat shows a survey made by me of the property described on this plat, and that the corners are correctly placed as shown, and that all locations have been correctly shown.

Surveyed For Merle Holger

Date January 1968

By Charla Days gi


Description:

Lot 16, and the East 2 of Lot 15.

Block G

Northwood Heights

Romsey County, Minn

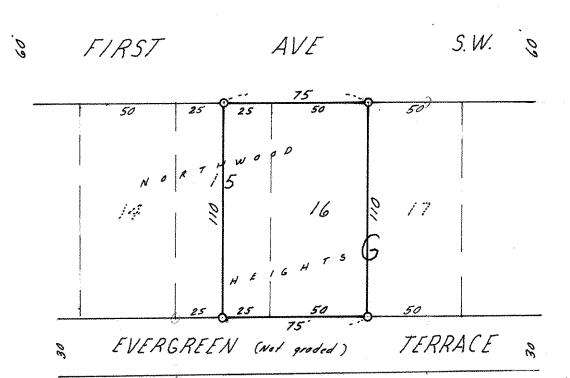

O Denotes Iron Monument