

CERTIFICATE OF SURVEY

MILNER W. CARLEY
CIVIL ENGINEER & SURVEYOR

500 W. Hwy. 96


IV. 4-3321

Scale 1" = 30'

I hereby certify that this survey, plan, or report was prepared by me or under my direct supervision and that I am a duly Registered Land Surveyor under the laws of the State of Minnesota.

Robert W. Knudson

Date Feb. 20, 1968 Reg. No. 5135

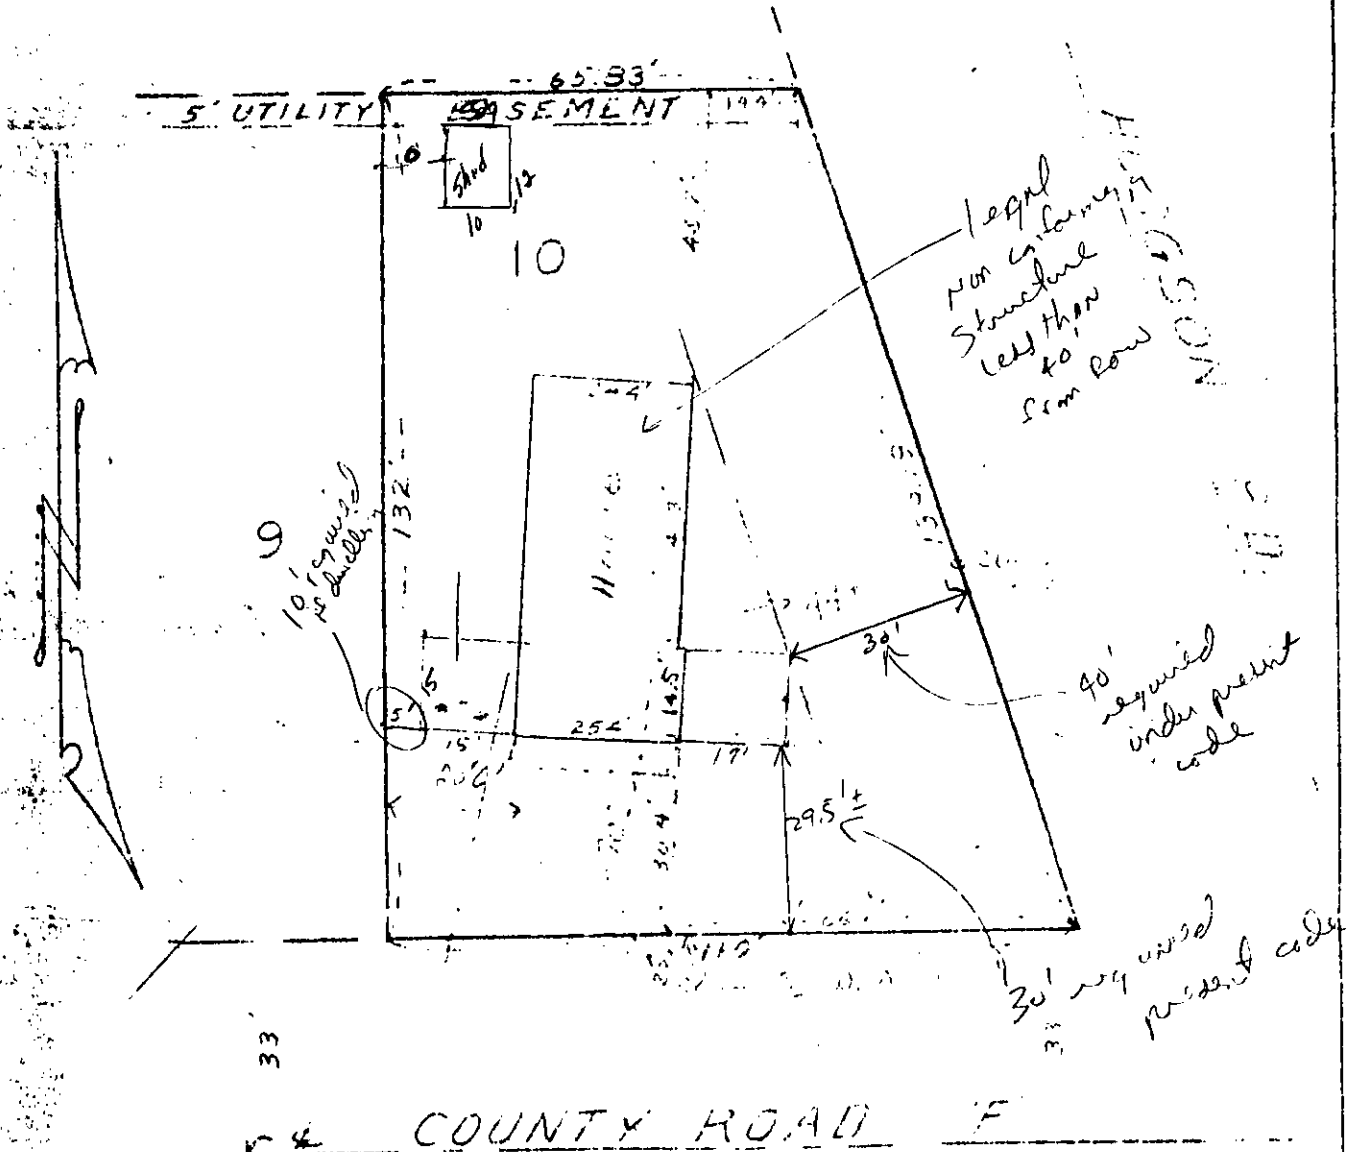

Lot 10, Block 11 Windward Heights No. 4
Ramsey County, Minnesota

8791

58-23
172-49