NW 2.29.23

FROM THE OFFICE OF

CHARLES O. GEORGI COMPANY

2215 West County Road B — Saint Paul, Minnesota 55113

REGISTERED CIVIL ENGINEER AND LAND SURVEYOR

Certificate of Survey

I Hereby Certify that this plat shows a building location survey made by me on the property described on this plat, and that all locations, have been correctly shown.

Date Oct 1969

Scale 1" = 100'

By Charles O. Georgi
REGISTERED LAND SURVEYOR

For Mary Bullick

Description:

Part of the NW¼ of SW¼ of section 2, T29 R23, described as follows: Beginning at a point 752.49 feet South of NE Corner of the W½ of W½ of SW¼ of section, 2, T29, R23, thence South 83.54 feet thence East 521.49 feet, thence North 83.54 feet to a point 136.3 feet West and 752.49, feet South of NE Corner of the W½ of SW¼ of said Section 2, thence West to point of beginning subject to Oxford St.
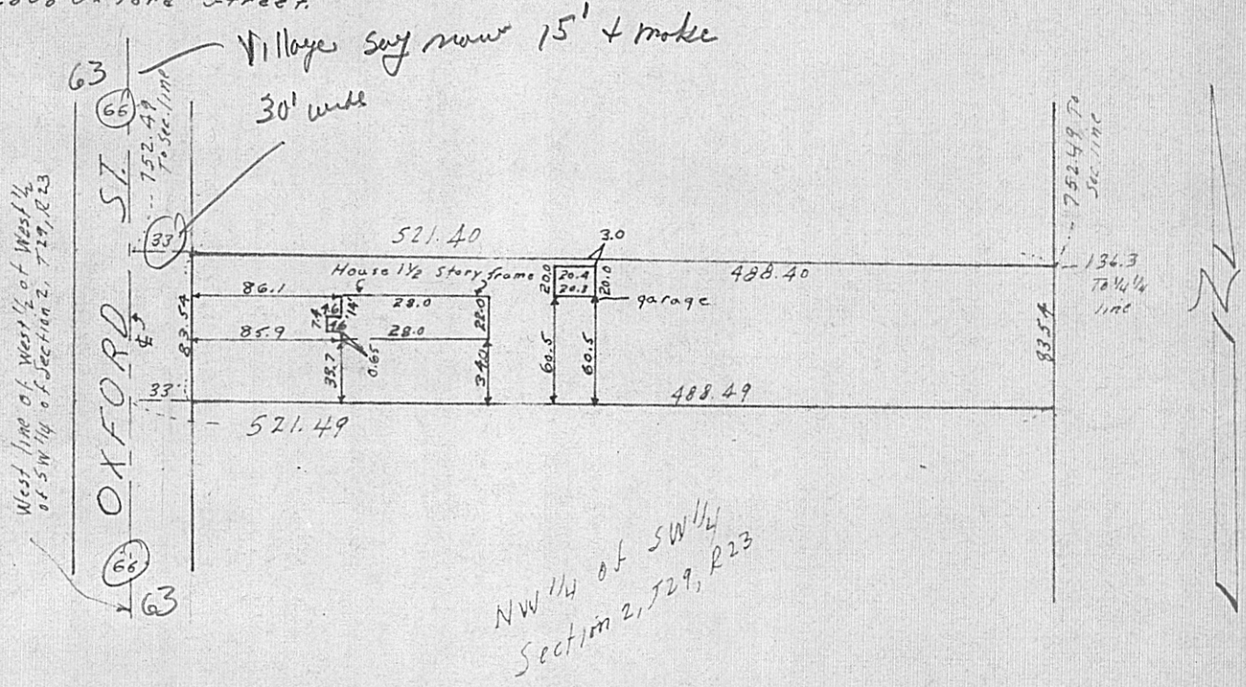
2808 Oxford Street