SE 8, 29, 23

FROM THE OFFICE OF

CHARLES O. GEORGI COMPANY

2215 West County Road B — Saint Paul, Minnesota 55113

REGISTERED CIVIL ENGINEER AND LAND SURVEYOR

Certificate of Survey

File - "Agor"

For: J. S. Lind

I Hereby Certify that this plat shows a building location survey made by me on the property described on this plat, and that all locations, have been correctly shown. No corners placed herewith. House location to scale. 5/13 - Revised descriptions and dwg. 5/15/69 Exclude Fulham St. layout per owners request.

Date 25, APRIL 1969

Scale 1" = 50'

By Charles O. Georgi
REGISTERED LAND SURVEYOR

Description:
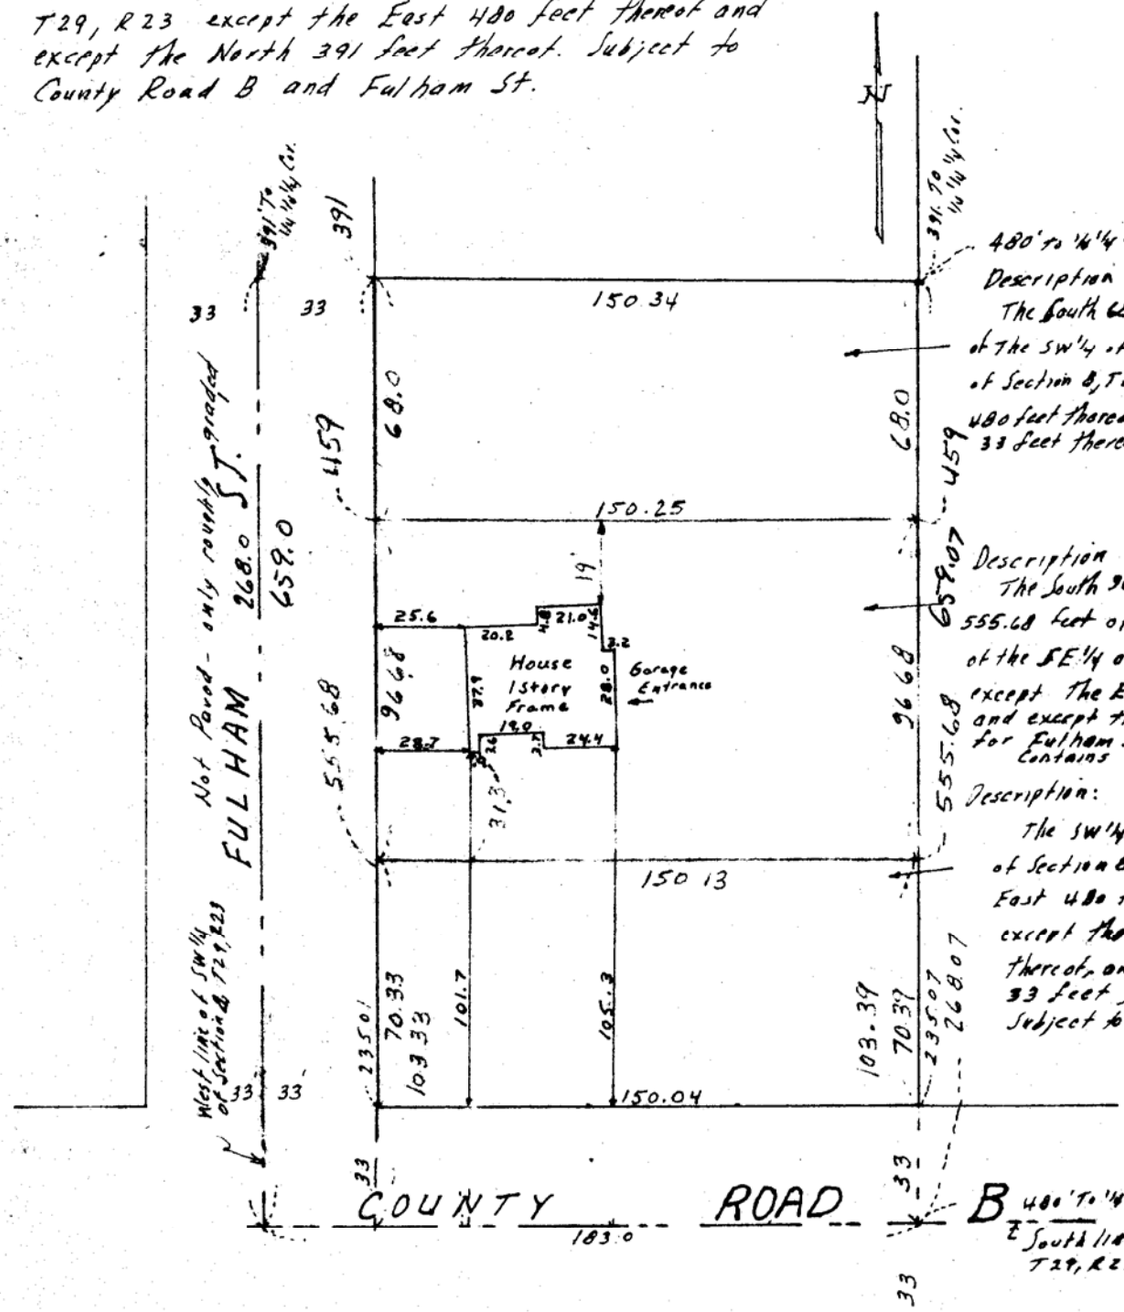
The SW 1/4 of the SW 1/4 of SE 1/4 of Section 8, T29, R23 except the East 480 feet thereof and except the North 391 feet thereof. Subject to County Road B and Fulham St.