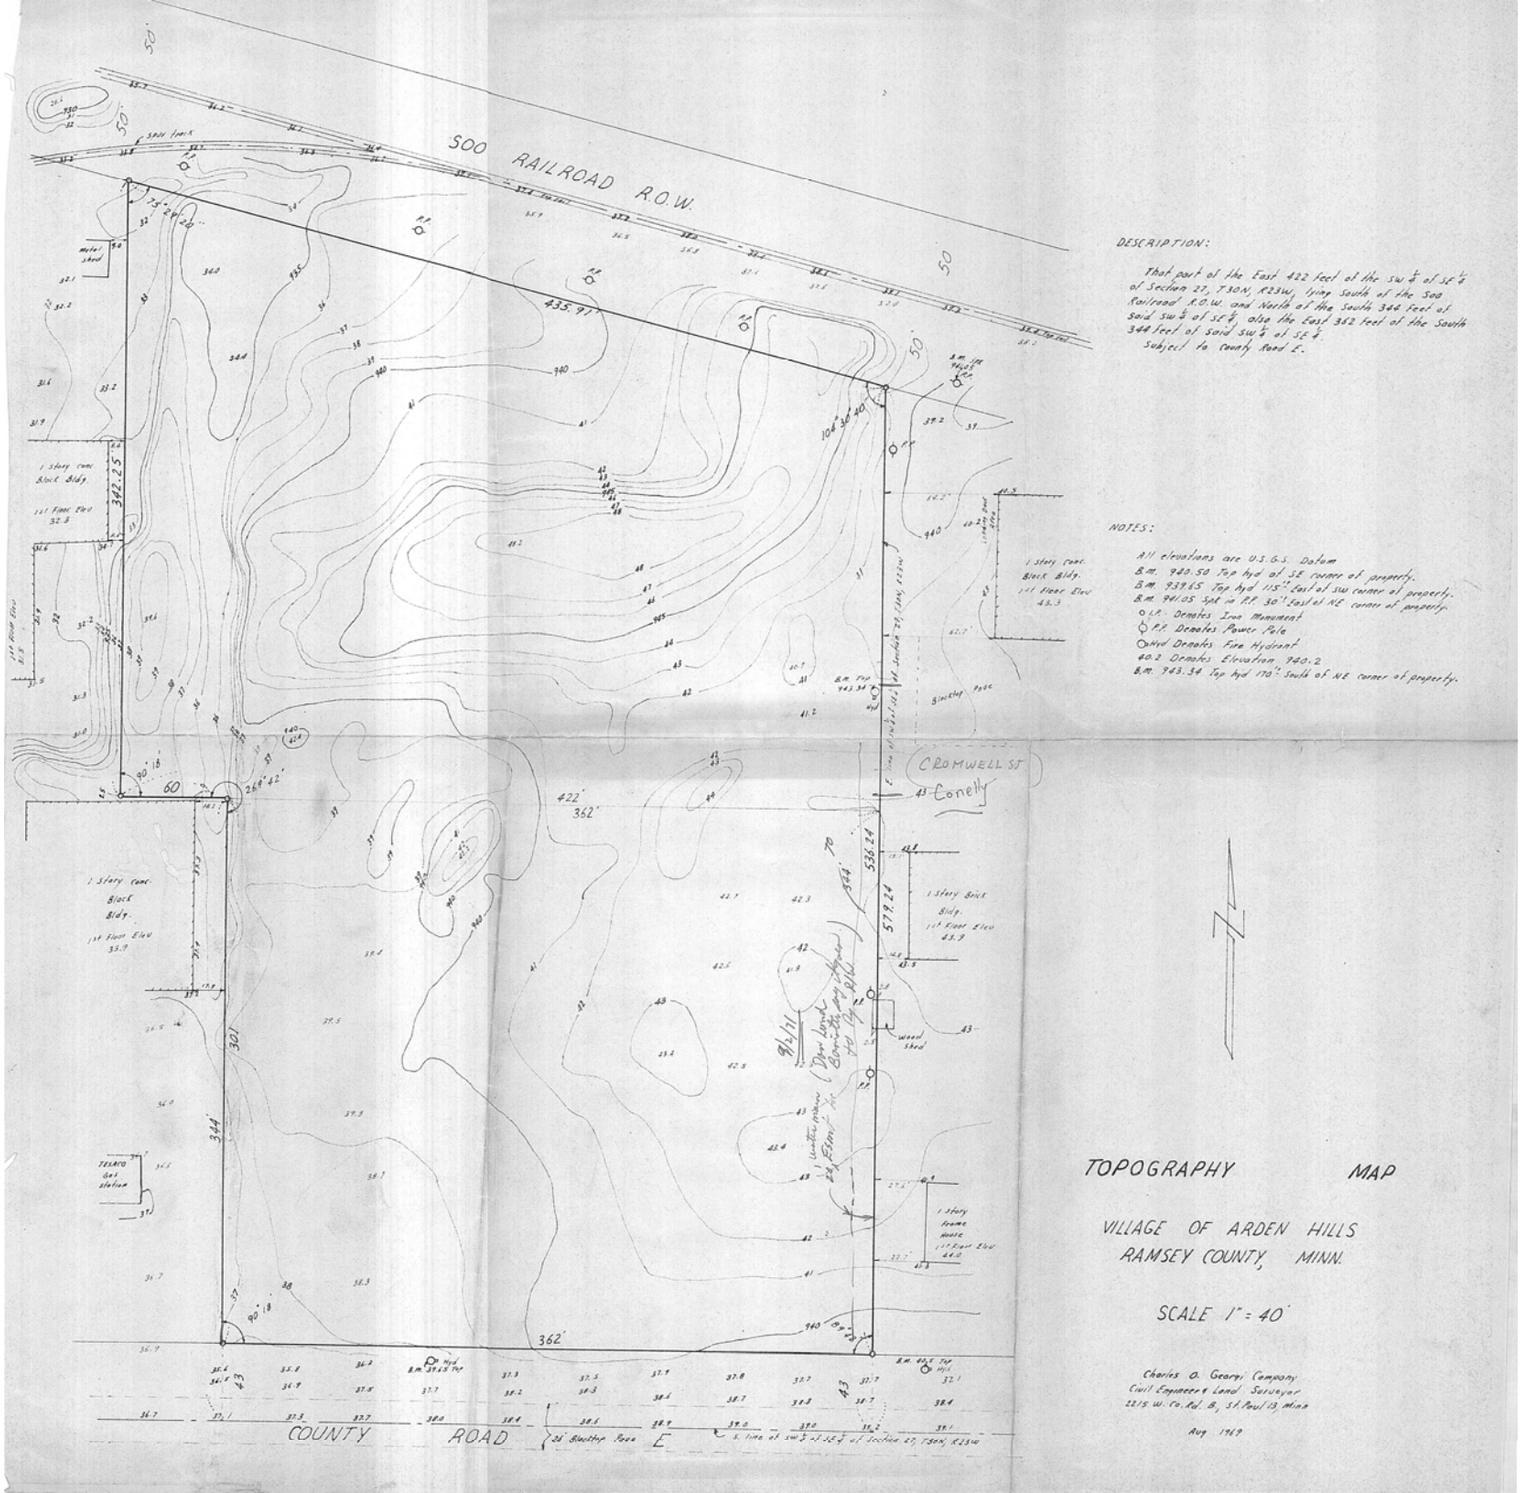

DESCRIPTION:

That part of the East 422 feet of the SW ¼ of SE ¼ of Section 27, T30N, R23W, lying South of the Soo Railroad R.O.W. and North of the South 344 feet of said SW ¼ of SE ¼ also the East 362 feet of the South 344 feet of said SW ¼ of SE ¼.
Subject to County Road E.

NOTES:

All elevations are U.S.G.S. Datum
B.M. 940.50 Top hyd at SE corner of property.
B.M. 939.15 Top hyd 115'± East of SW corner of property.
B.M. 941.05 Set on P.P. 30'± East of NE corner of property.
○ I.P. Denotes Iron Monument
○ P.P. Denotes Power Pole
○ Hyd Denotes Fire Hydrant
40.2 Denotes Elevation 940.2
B.M. 943.34 Top hyd 170'± South of NE corner of property.

TOPOGRAPHY MAP

VILLAGE OF ARDEN HILLS
RAMSEY COUNTY, MINN.

SCALE 1" = 40'

Charles O. Georgi Company
Civil Engineers & Land Surveyor
2215 W. Co. Rd. B, St. Paul 13, Minn.

Aug 1969