

CERTIFICATE OF SURVEY

MILNER W. CARLEY & ASSOCIATES

CONSULTING CIVIL ENGINEERS LAND SURVEYORS


500 W. HWY. 96
ST. PAUL 12, MINN.
484-3301

314 OAK ST.
SAUK CENTRE, MINN.
352-3664

18 4TH AVE. S.E.
ST. CLOUD, MINN.
251-7751

I hereby certify that this survey, plan, or report was prepared by me or under my direct supervision and that I am a duly Registered Land Surveyor under the laws of the State of Minnesota.

Reg. No. 3527 Date June 10, 1969

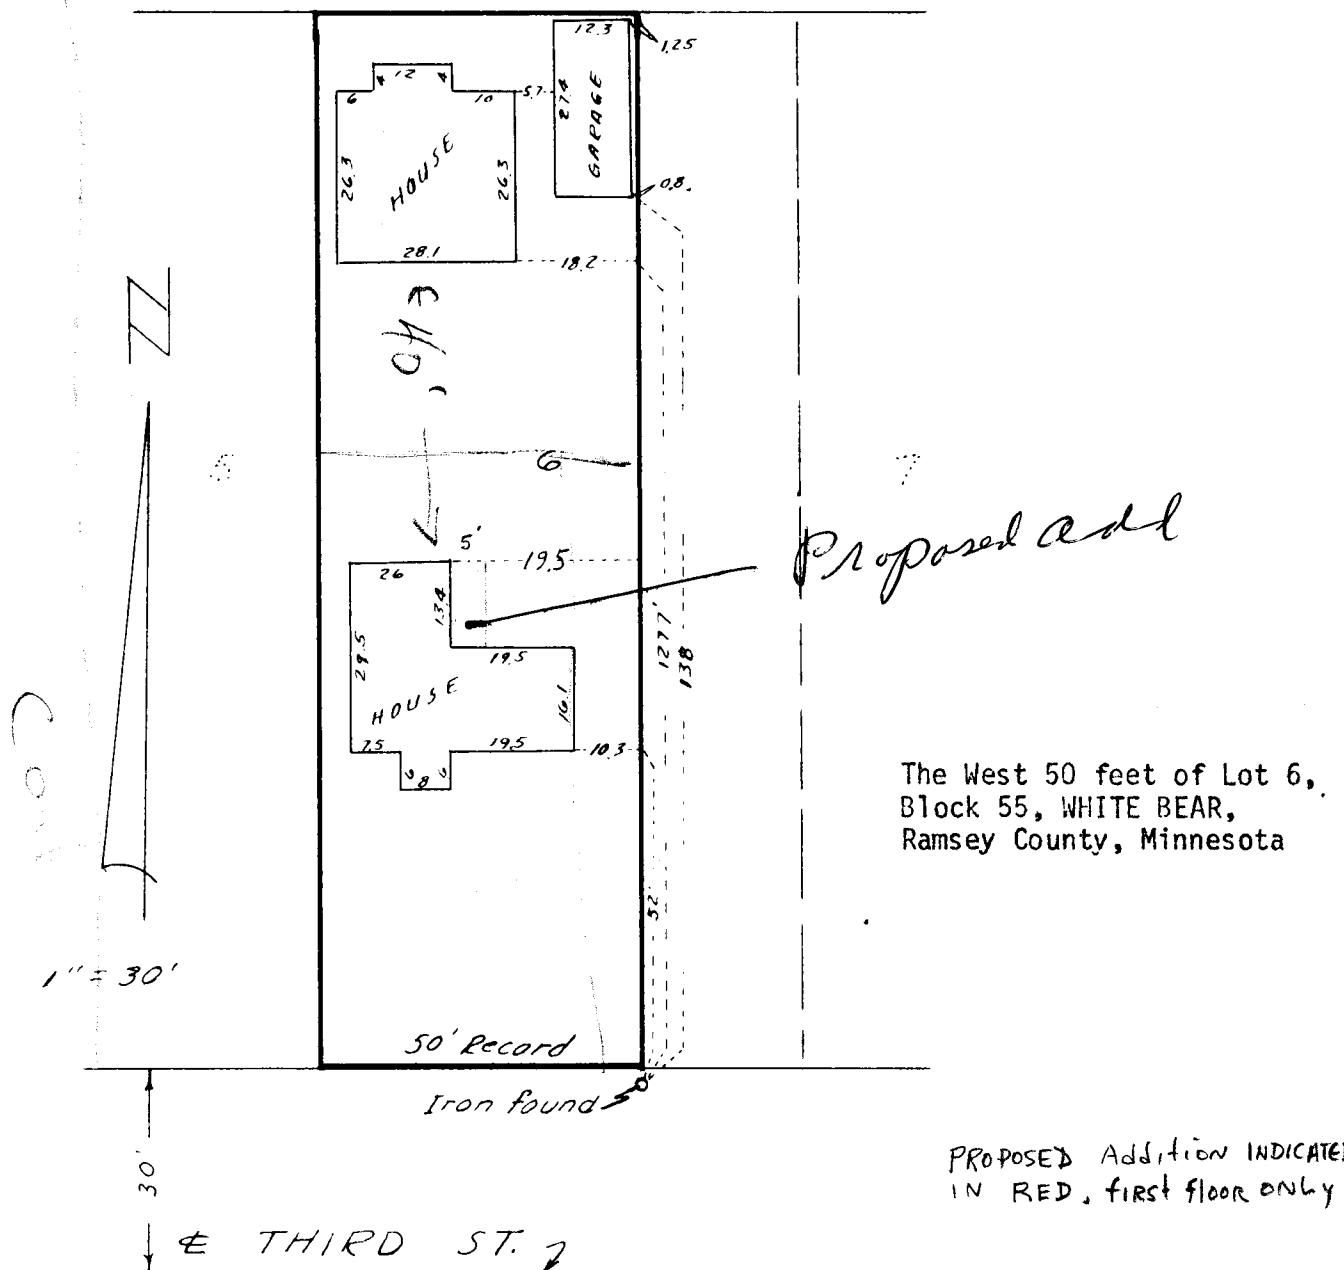

The West 50 feet of Lot 6,
Block 55, WHITE BEAR,
Ramsey County, Minnesota

PROPOSED Addition INDICATED
IN RED, first floor only.

2247 3rd St

69-121

69-228
371-67