FROM THE OFFICE OF

Certificate of Survey

CHARLES O. GEORGI COMPANY

2215 West County Road B

Saint Paul, Minnesota 55113

REGISTERED CIVIL ENGINEER AND LAND SURVEYOR

I Hereby Certify that this plat shows a survey made by me of the property described on this plat, and that the corners are correctly placed as shown, and that all locations have been correctly shown. Corners placed in 1968


Date March 1969

y hours Longi
REGISTERED LAND SURVEYOR

Description:

Lot 10 Block 16

Lakeview Hills No.6

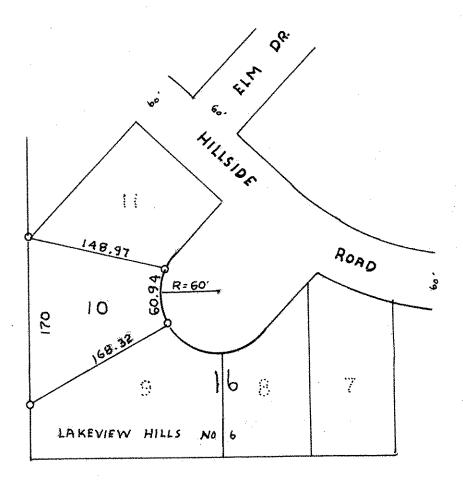

O Denotes Iron Monument