NE 17, 29, 22

FROM THE OFFICE OF

CHARLES O. GEORGI COMPANY

2215 West County Road B Saint Paul, Minnesota 55113

REGISTERED CIVIL ENGINEER AND LAND SURVEYOR

Certificate of Survey

I Hereby Certify that this plat shows a survey made by me of the property described on this plat, and that the corners are correctly placed as shown, and that all locations have been correctly shown.

Surveyed For John J. Moore

Date April 1969

Scale 1" = 40'

By Charles O. Georgi
REGISTERED LAND SURVEYOR

Description:
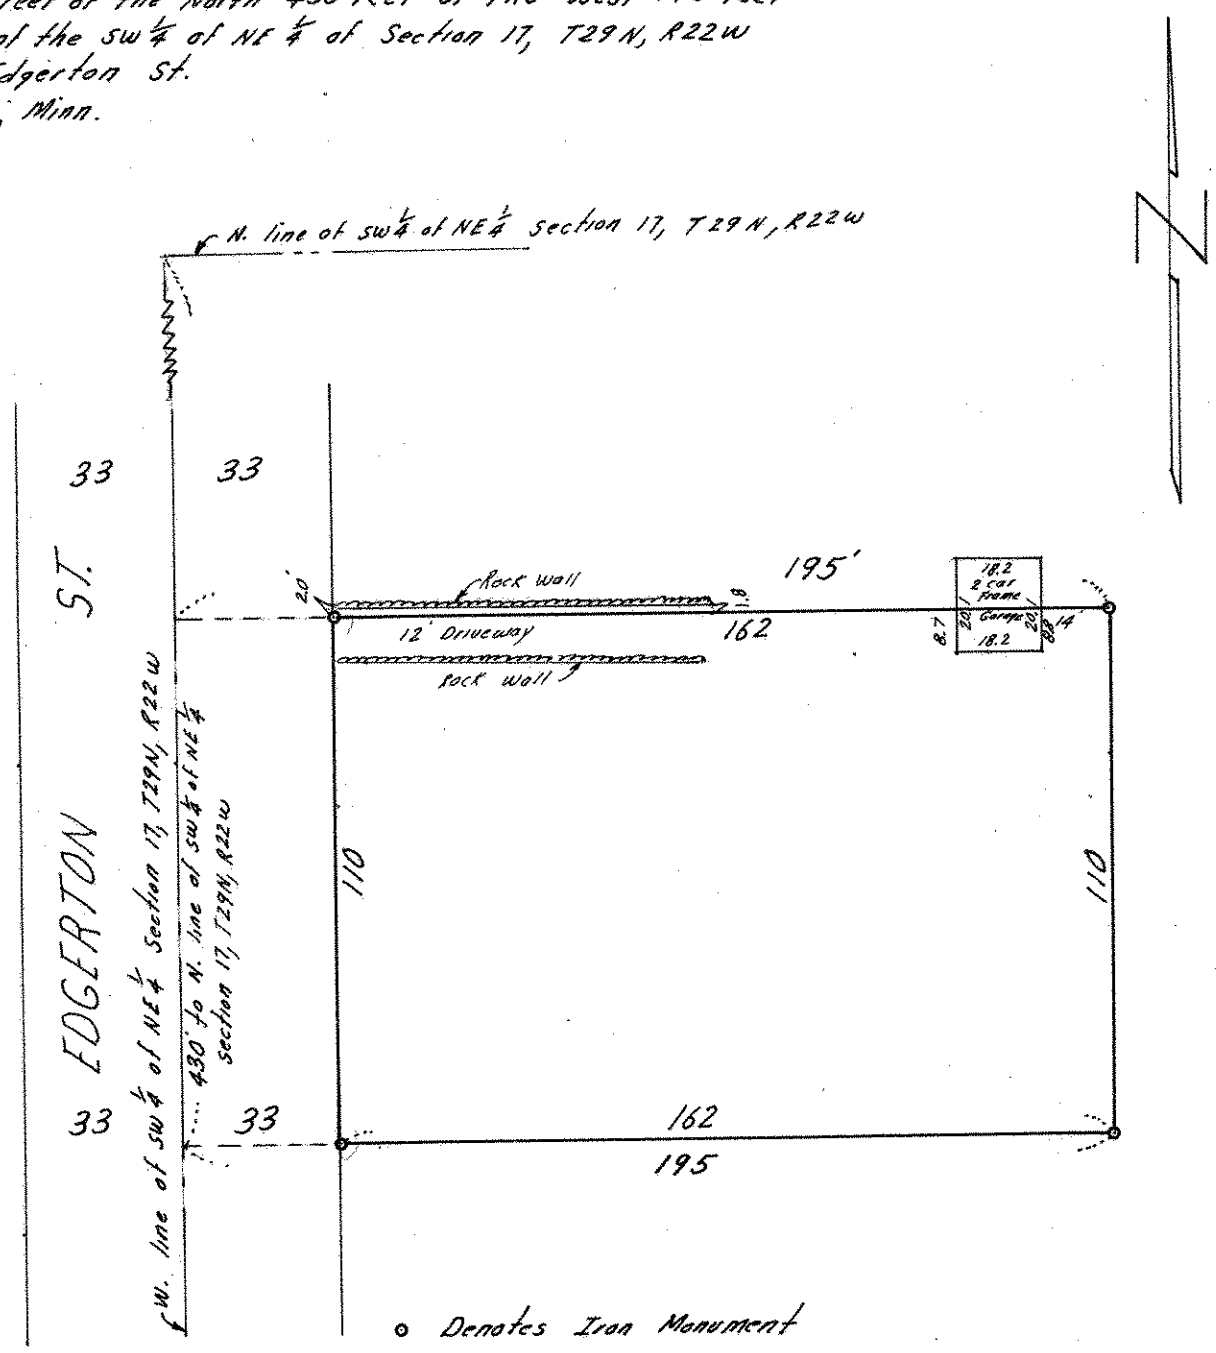
The South 110 feet of the North 430 feet of the West 195 feet of the West ½ of the SW ¼ of NE ¼ of Section 17, T29N, R22W
Subject to Edgerton St.
Ramsey County, Minn.