NE 11 29 22

FROM THE OFFICE OF

CHARLES O. GEORGI COMPANY

2215 West County Road B Saint Paul, Minnesota 55113

REGISTERED CIVIL ENGINEER AND LAND SURVEYOR

Certificate of Survey

I Hereby Certify that this plat shows a survey made by me of the property described on this plat, and that the corners are correctly placed as shown, and that all locations have been correctly shown.

Surveyed For William McIntyre

Date March 1969

Scale 1" = 30'

By Charles O. Georgi
REGISTERED LAND SURVEYOR

Description:
The North 163.5 feet of the East 110 feet of the West 625 feet of Lot 6, E. G. Rogers Garden Lots subject to use of Brooks Ave over the North 30 feet and the use of Germain St. over the East 10 feet thereof.

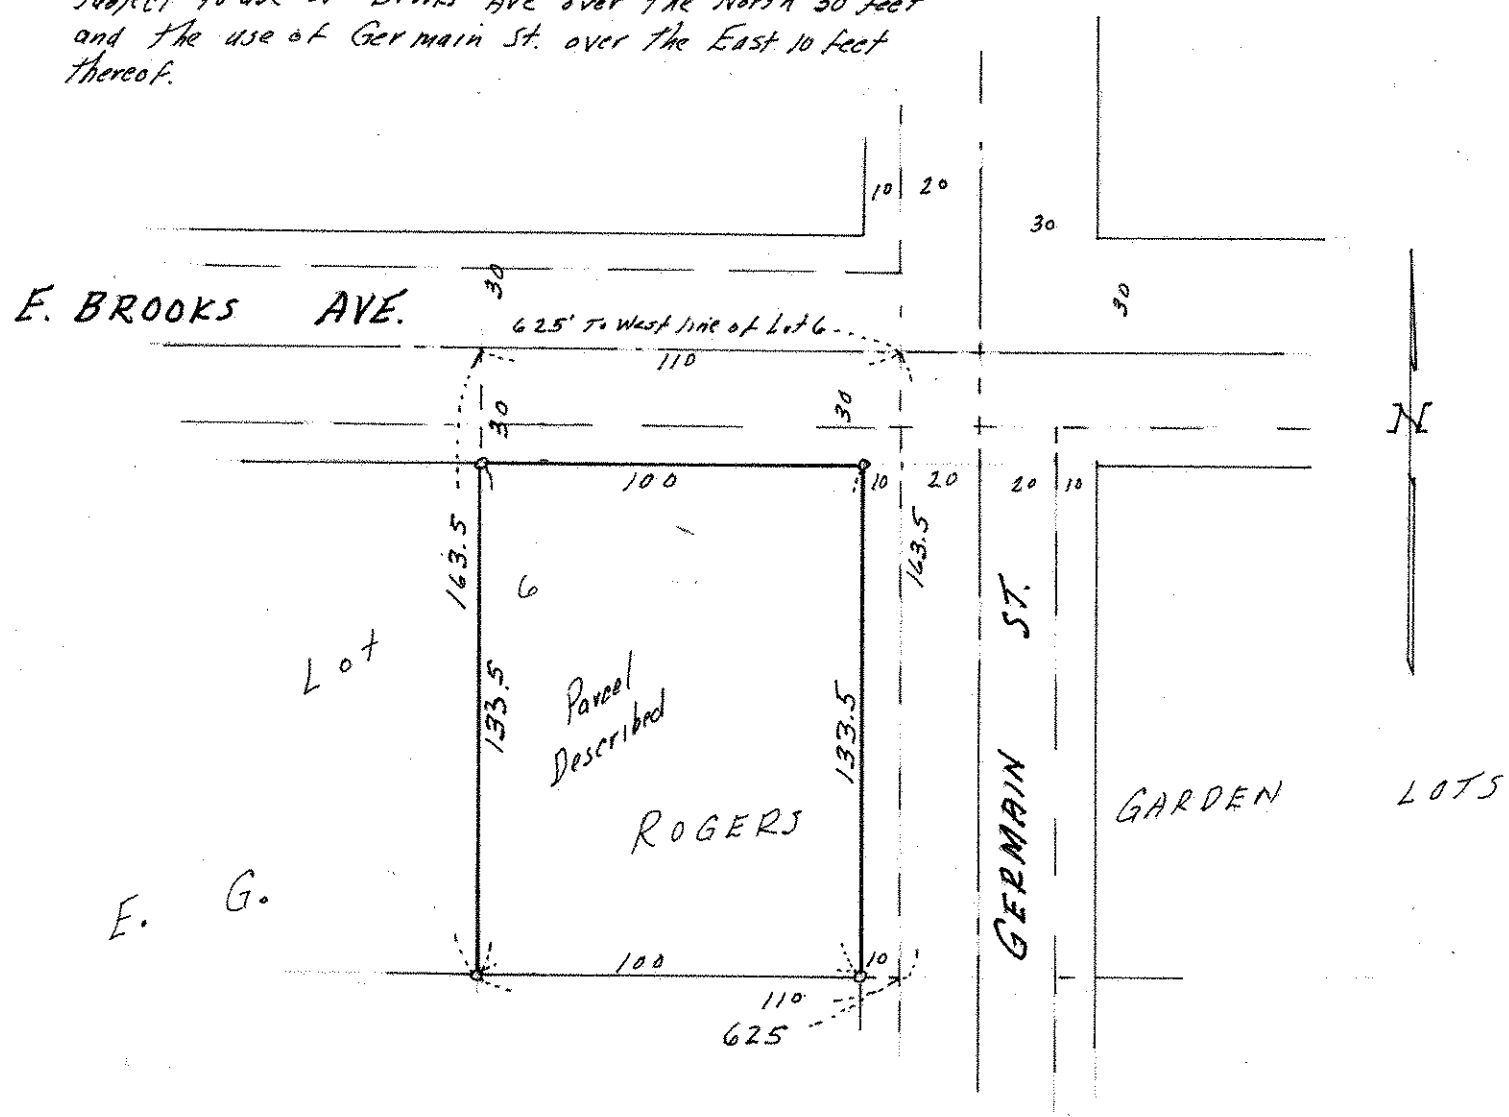

o Denotes Iron Monument.