FROM THE OFFICE OF

CHARLES O. GEORGI COMPANY

2215 West County Road B — Saint Paul 8, Minnesota

MINNESOTA REGISTERED LAND SURVEYOR

Certificate of Survey

I Hereby Certify that this plat shows a ~~true~~ survey made ~~by me~~ as requested for boundary survey of the property described on this plat, and that the corners are correctly placed as shown, and that all locations, encroachments, etc., have been correctly shown.

Surveyed For Ban Con Inc.

Date December 1968

Scale 1" = 50'

By _____
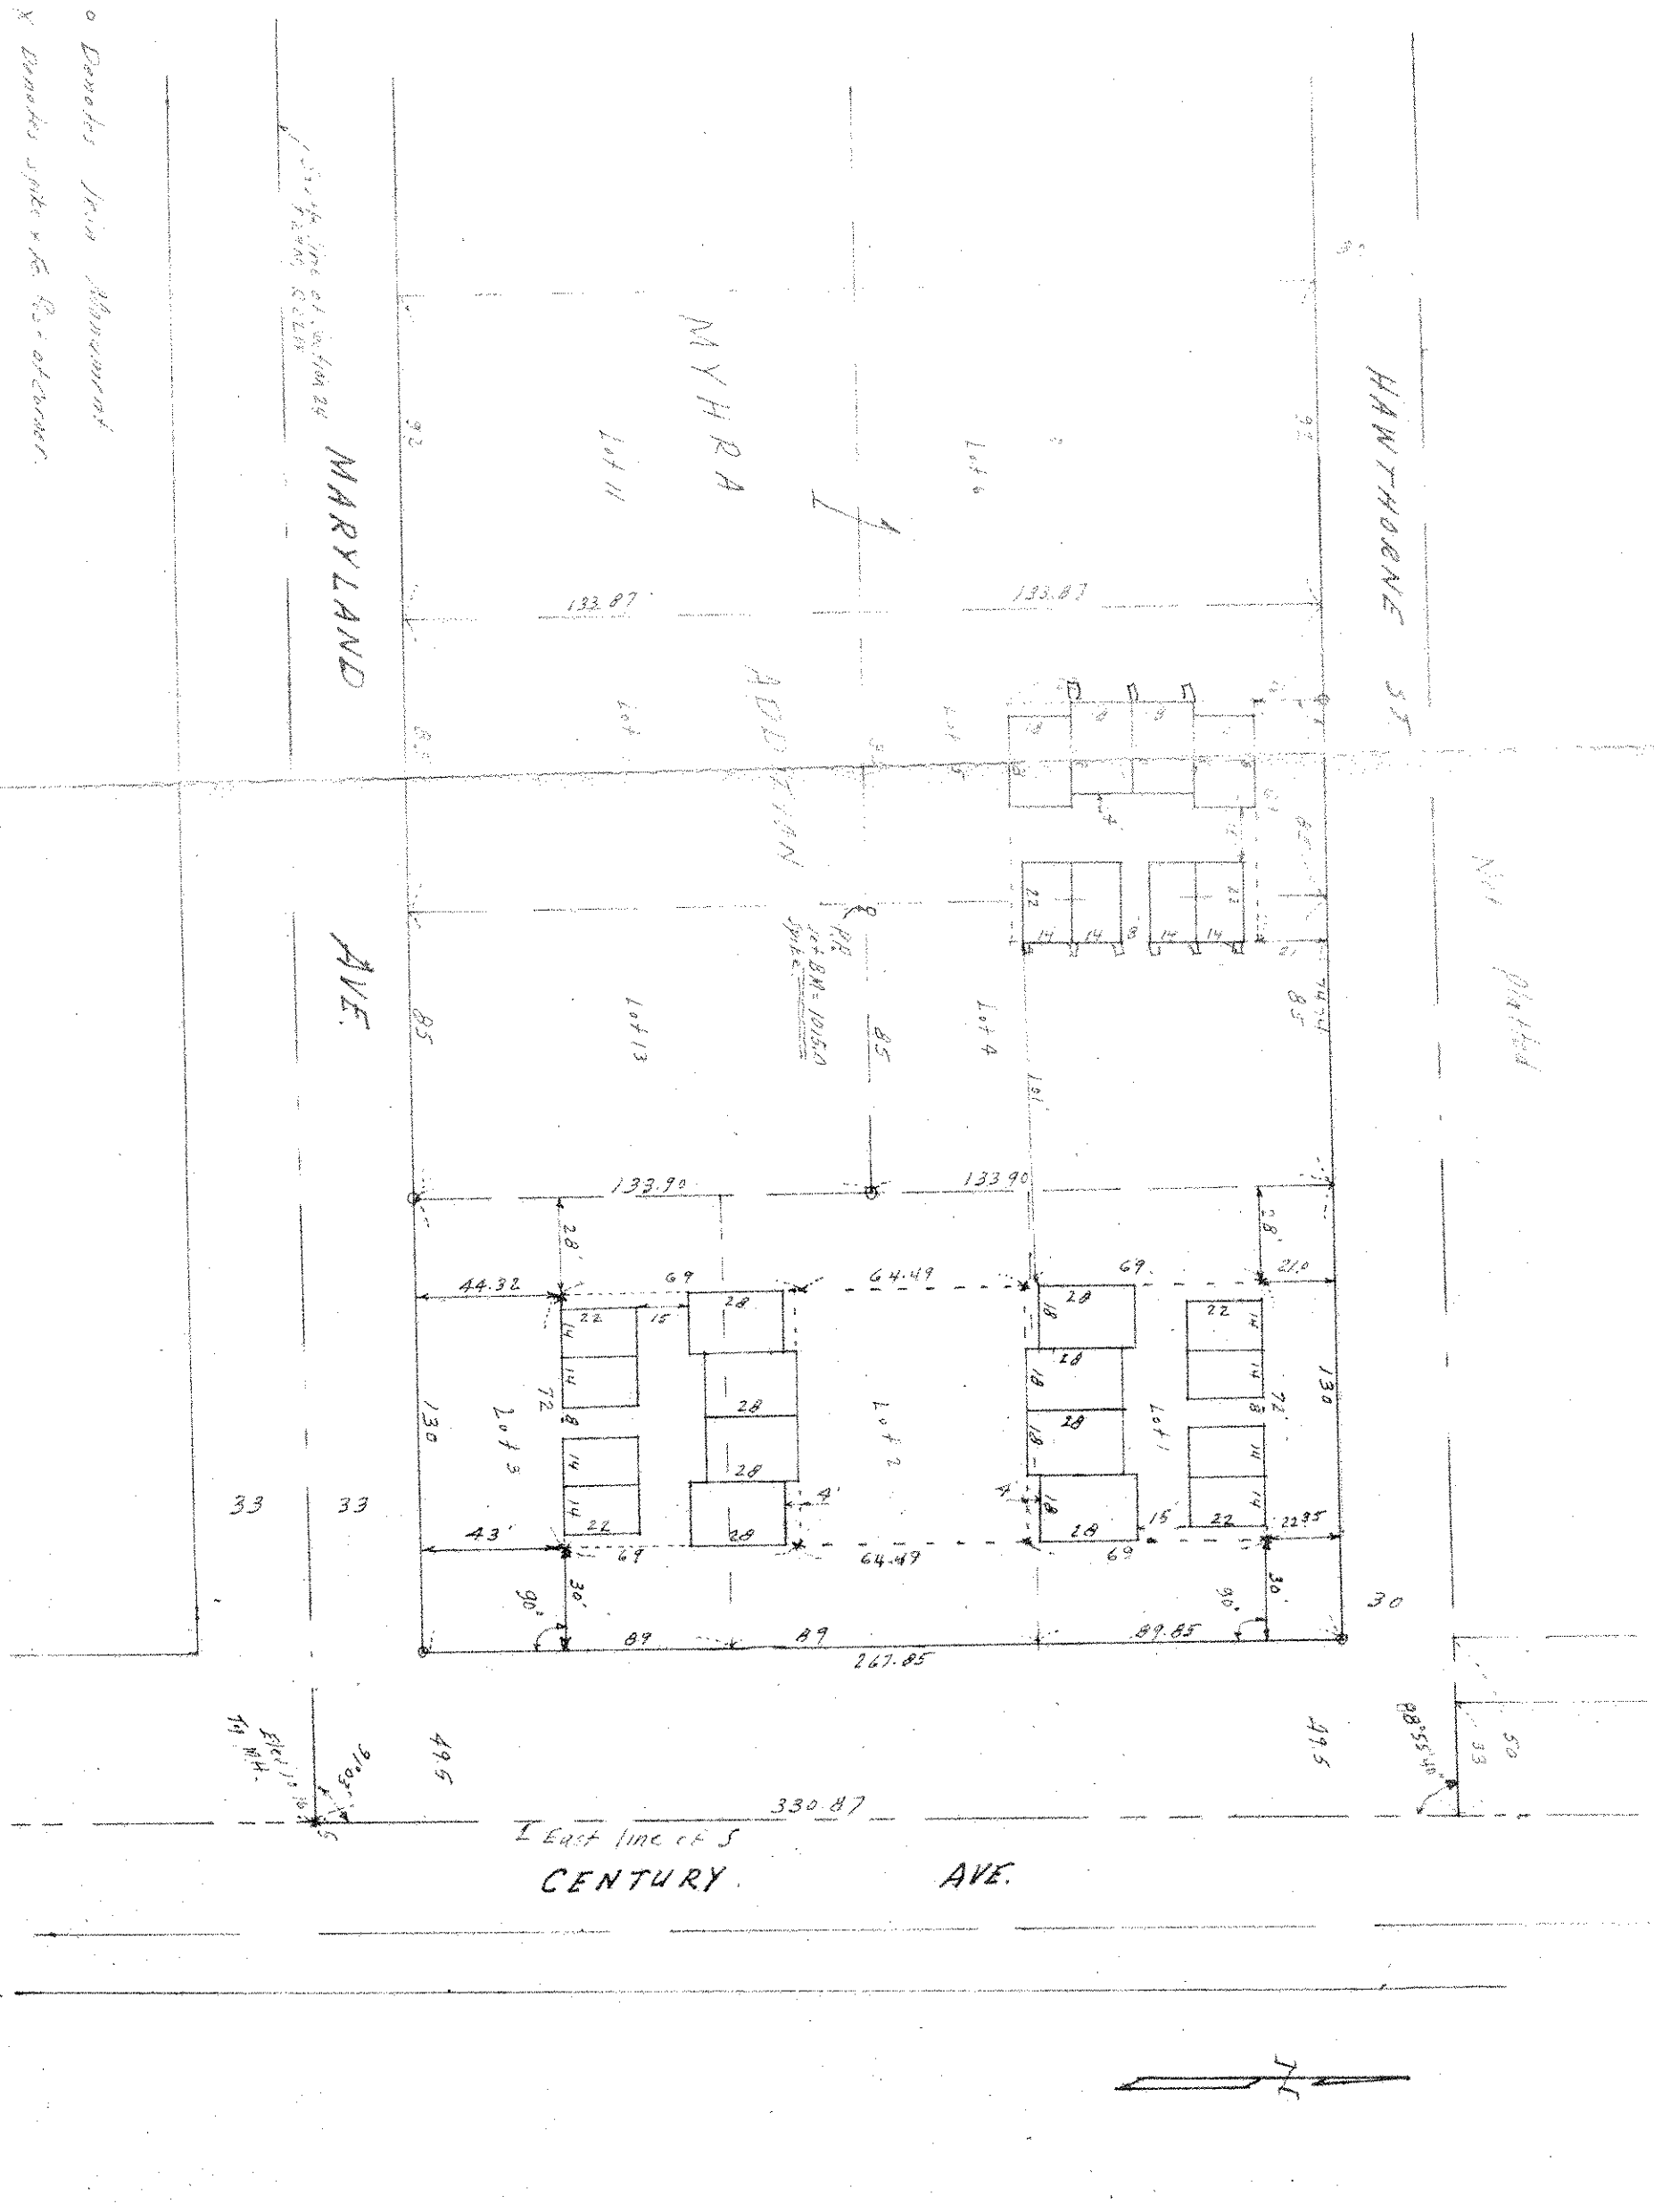
REGISTERED LAND SURVEYOR