NE 11 28 22

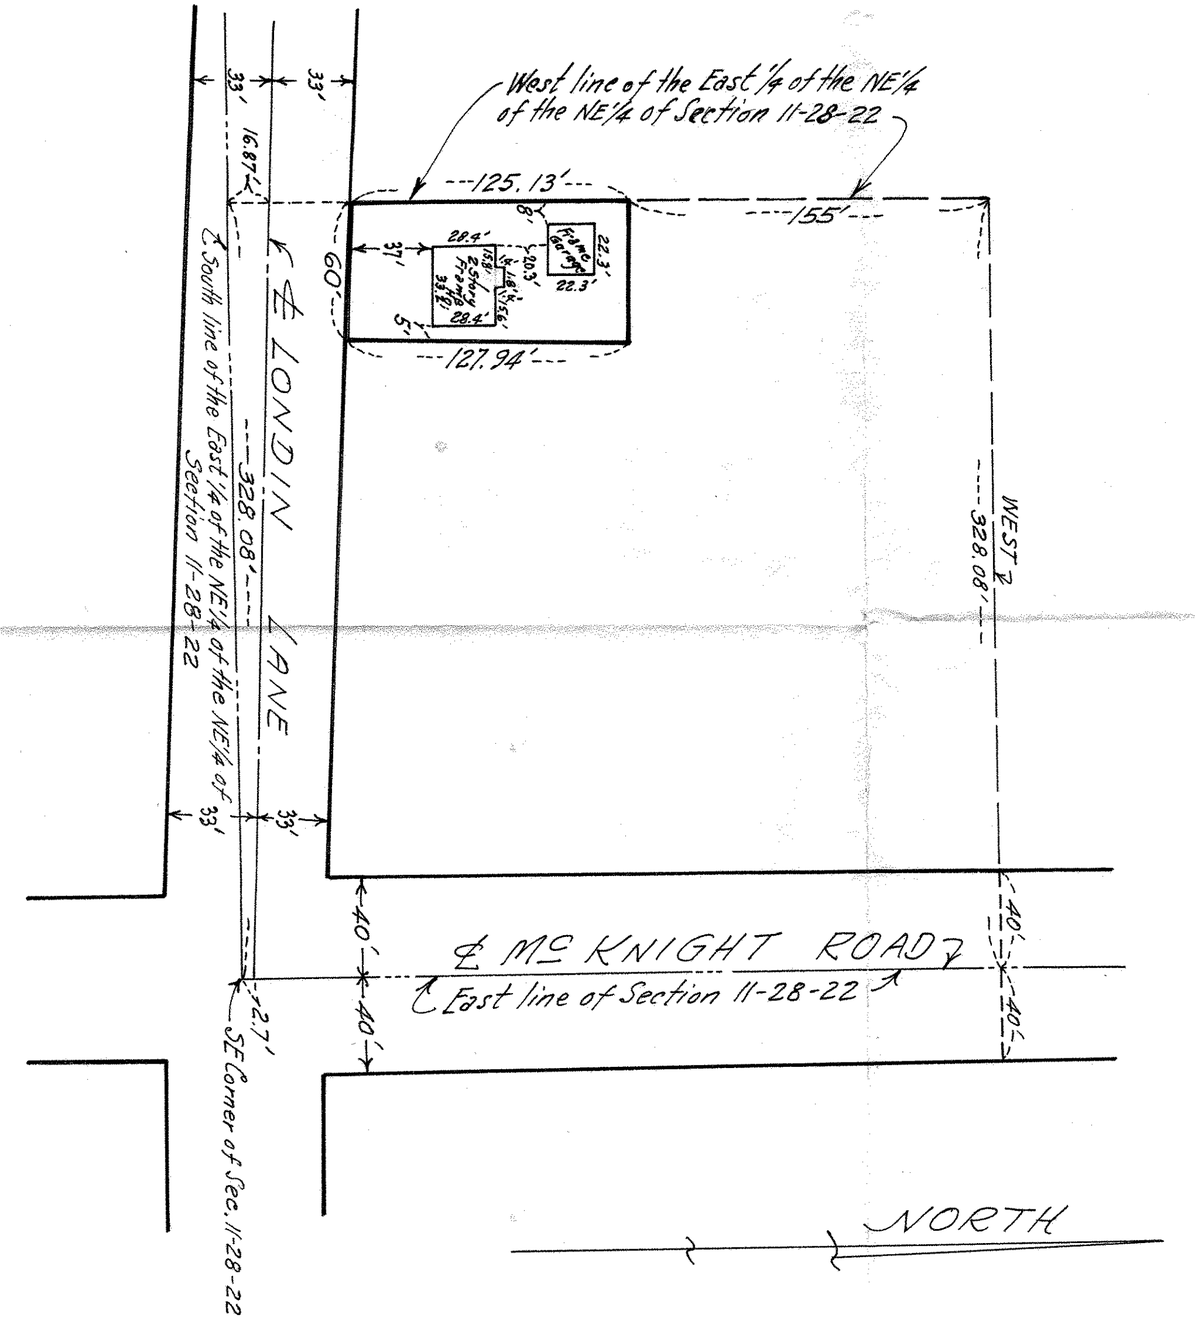

1967