

FROM THE OFFICE OF

CHARLES O. GEORGI COMPANY

2215 West County Road B

Saint Paul, Minnesota 55113

REGISTERED CIVIL ENGINEER AND LAND SURVEYOR



I Hereby Certify that this plat shows a survey made by me of the property described on this plat, and that the corners are correctly placed as shown, and that all locations have been correctly shown.

Surveyed For *Fred Kuemper Jr*


Date *Sept. 1st 1970*

Scale *1" = 50'*

By *Charles O. Georgi*
REGISTERED LAND SURVEYOR

Description:

*The South 126.4 feet of the East 83.7 feet of Lot 1,
Block 7, Rearrangement of White Bear Park,
Ramsey County, Minn.*

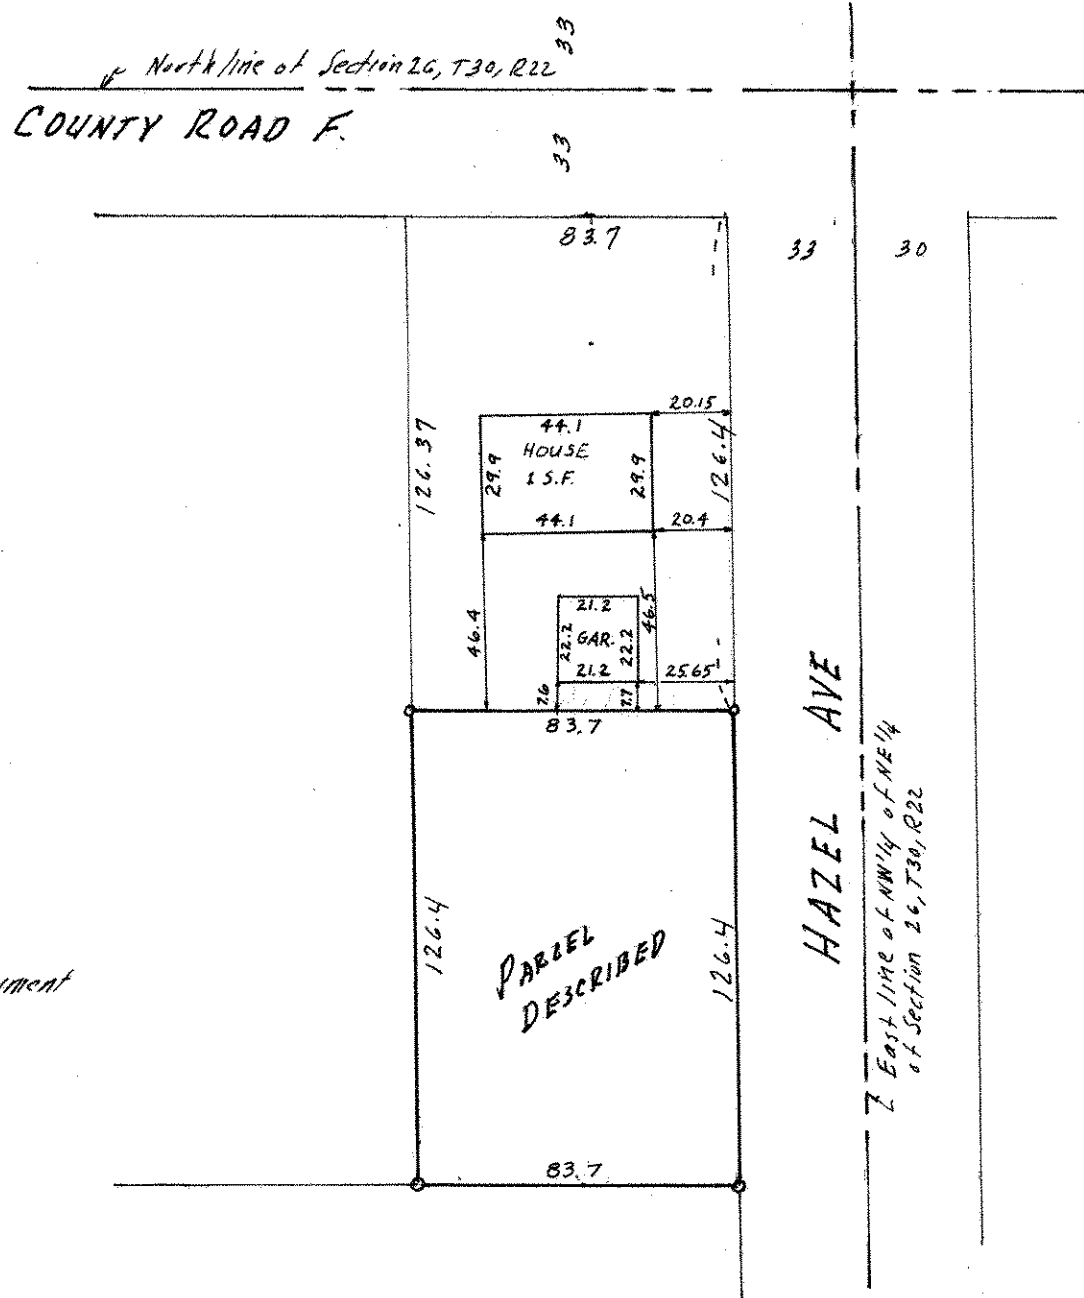

o Denotes Iron Monument