SE 6-29-22

FROM THE OFFICE OF

CHARLES O. GEORGI COMPANY

2215 West County Road B Saint Paul, Minnesota 55113

REGISTERED CIVIL ENGINEER AND LAND SURVEYOR

Certificate of Survey

I Hereby Certify that this plat shows a building location survey made by me on the property described on this plat, and that all locations, have been correctly shown. Iron Monuments were placed as shown

Surveyed for: Glen R. Waber

Date July 1970

Scale 1" = 50'

By Charles O. Georgi
REGISTERED LAND SURVEYOR

Description:
The North 75 feet of lots 11, 12, & 13 of Block 5,
J. F. Eisenmenger's 4th Addition, Ramsey County, Minn

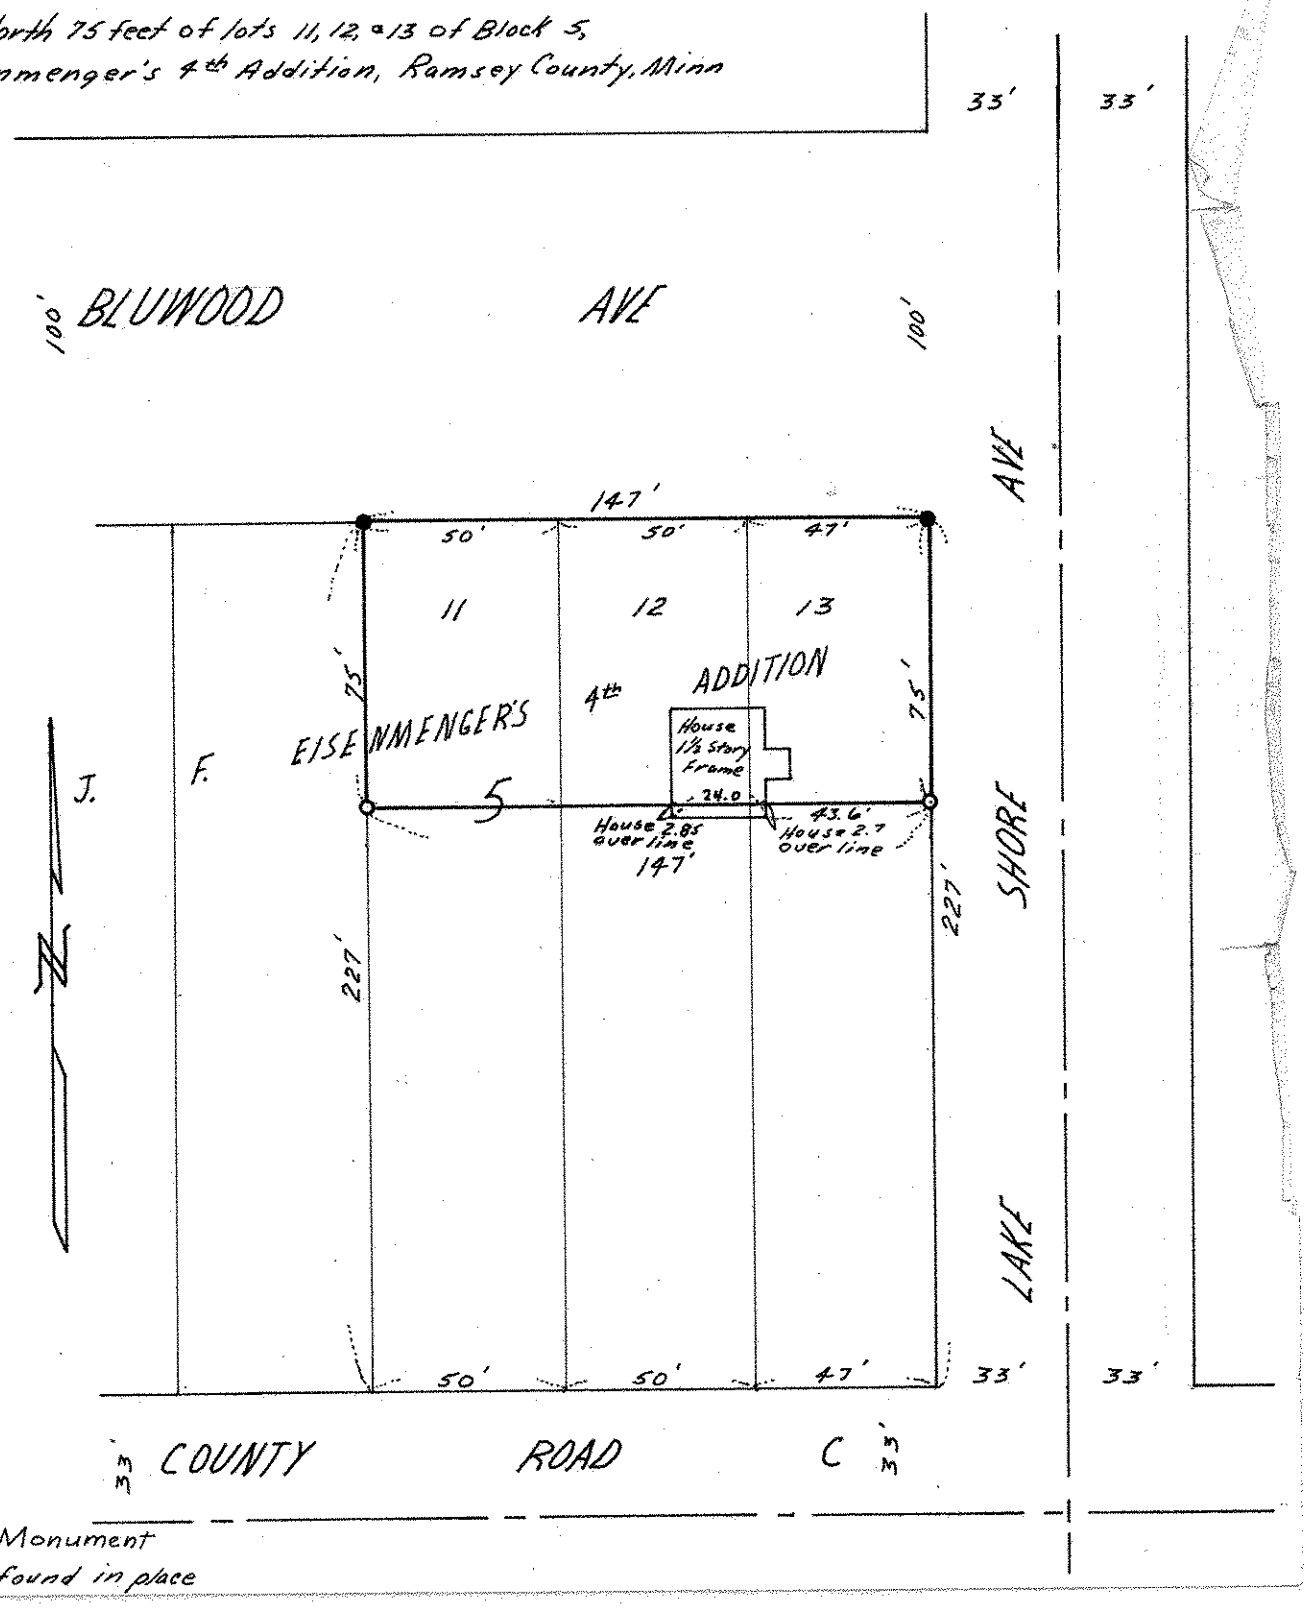

○ Denotes Iron Monument
● Denotes iron found in place