NW 32 29 23

FROM THE OFFICE OF

CHARLES O. GEORGI COMPANY

2215 West County Road B Saint Paul, Minnesota 55113

REGISTERED CIVIL ENGINEER AND LAND SURVEYOR

Certificate of Survey

I Hereby Certify that this plat shows a survey made by me of the property described on this plat, and that the corners are correctly placed as shown, and that all locations have been correctly shown.

Surveyed For Balco Tool Products

Date February 1970

Scale 1" = 40'

By Charles O. Georgi
REGISTERED LAND SURVEYOR
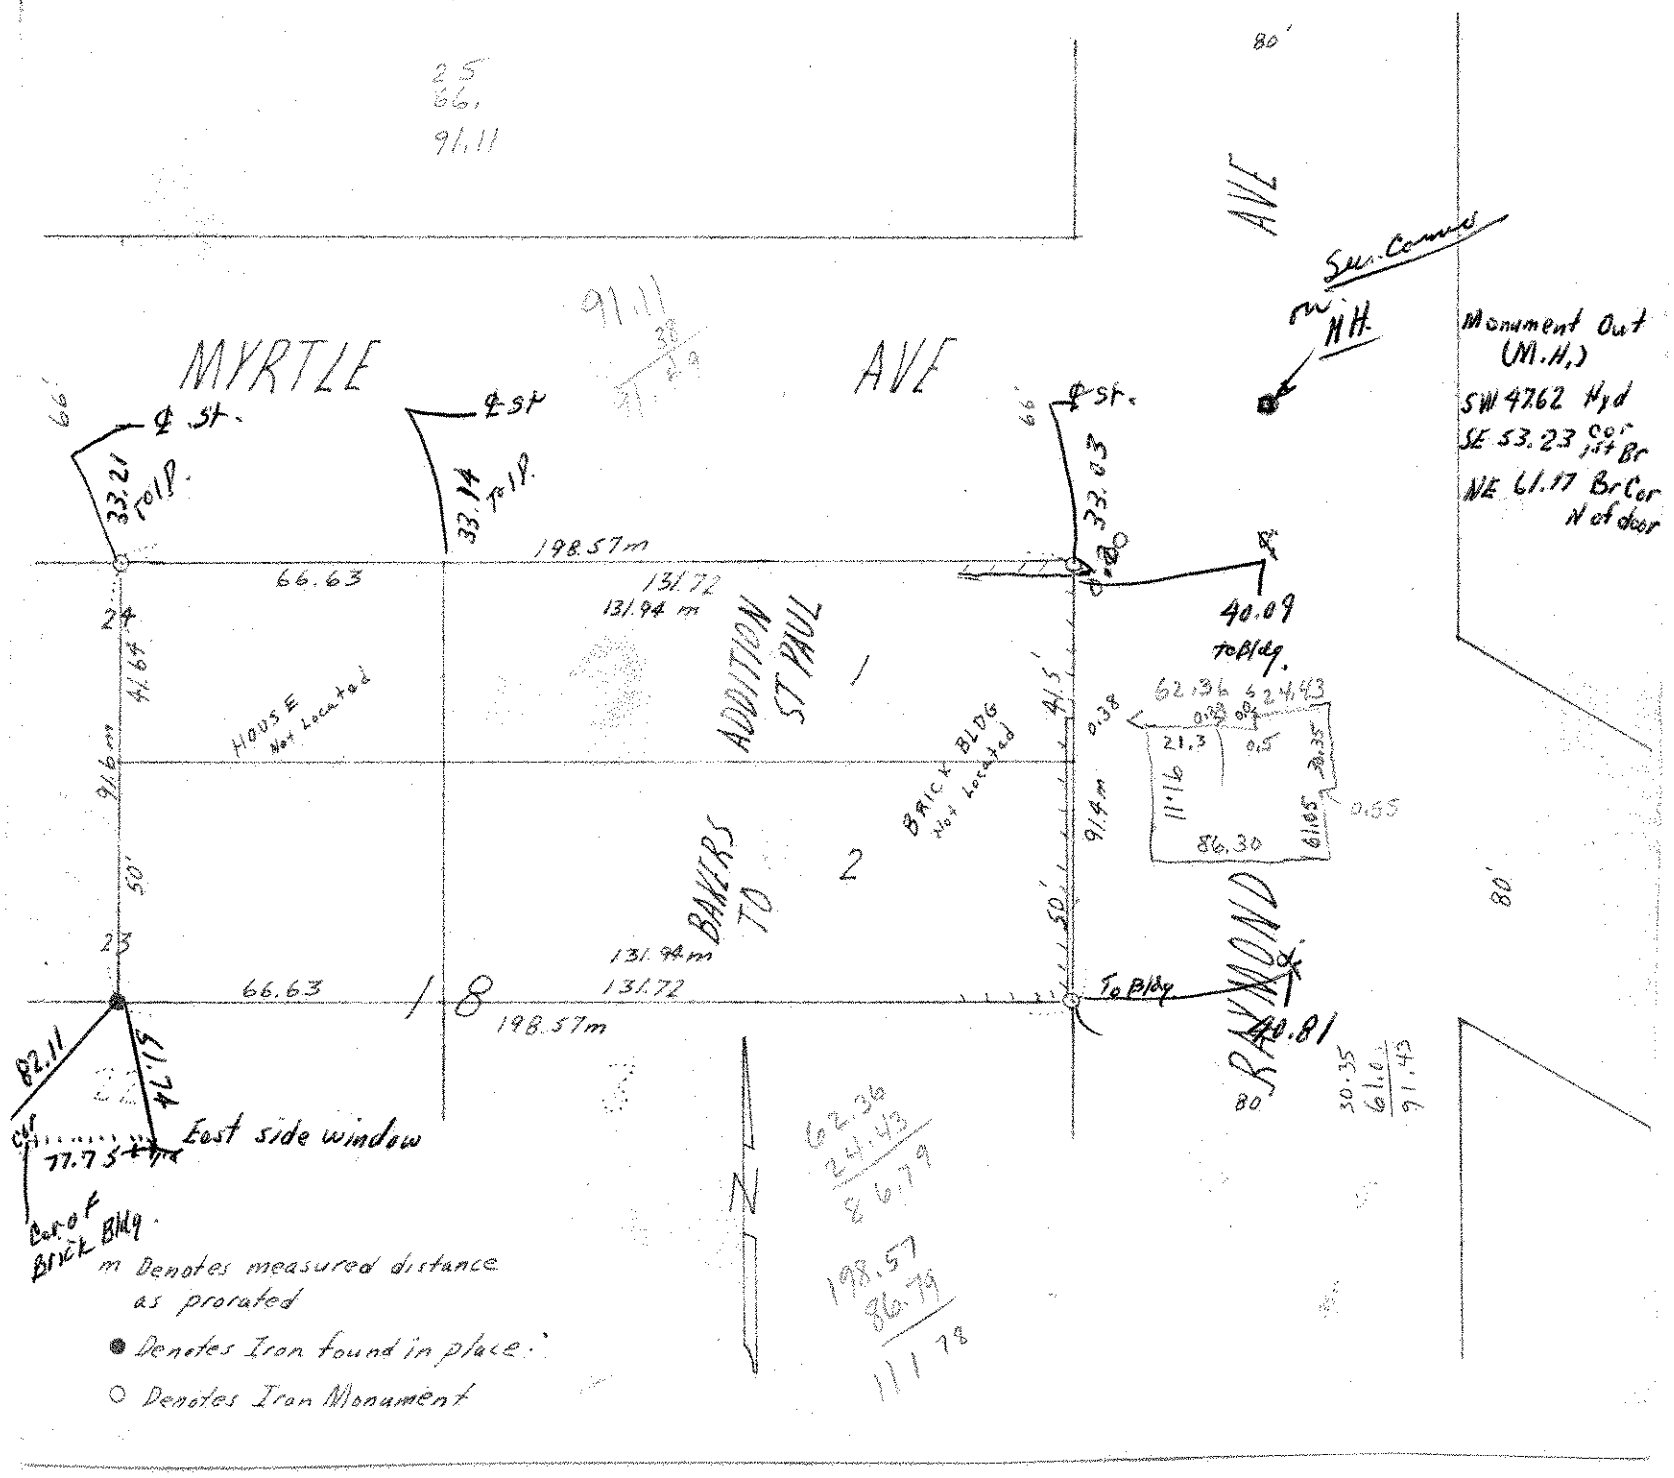
Description:
The East 66.63 feet of Lots 23 and 24, and all of Lots 1 and 2, Block 18 Bakers Addition to St Paul