

FROM THE OFFICE OF

# CHARLES O. GEORGI COMPANY

2215 West County Road B

Saint Paul, Minnesota 55113

REGISTERED CIVIL ENGINEER AND LAND SURVEYOR



I Hereby Certify that this plat shows a survey made by me of the property described on this plat, and that the corners are correctly placed as shown, and that all locations have been correctly shown.

Surveyed For David Miner.....

Date Aug. 1970.....


Scale 1" = 30'.....

By Charles O. Georgi  
REGISTERED LAND SURVEYOR

**Description:**

Lot 4,  
Block 4,  
Fooshe's East Home Add.,  
St. Paul, Ramsey County, Minnesota.

60 FREMONT AVE. 60

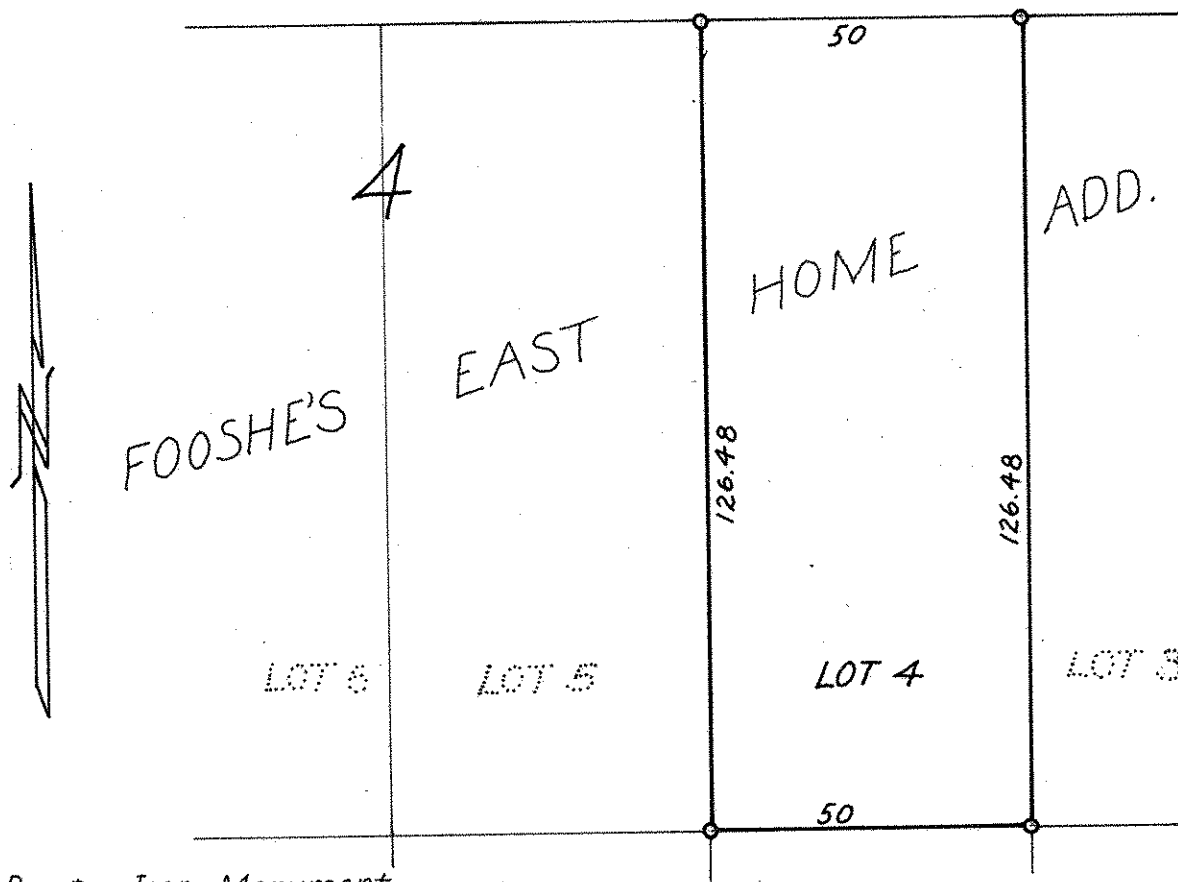

o Denotes Iron Monument