


CERTIFICATE OF SURVEY

Survey of Lot 4, Block 55, except the Southerly 75 feet.
White Bear Lake, Minnesota

Notes:
Drawing not to scale
Irons in place as shown -o-

Survey made only for:
Mr. Larry Perron
422 Fourth Street
White Bear Lake
Minnesota 55110

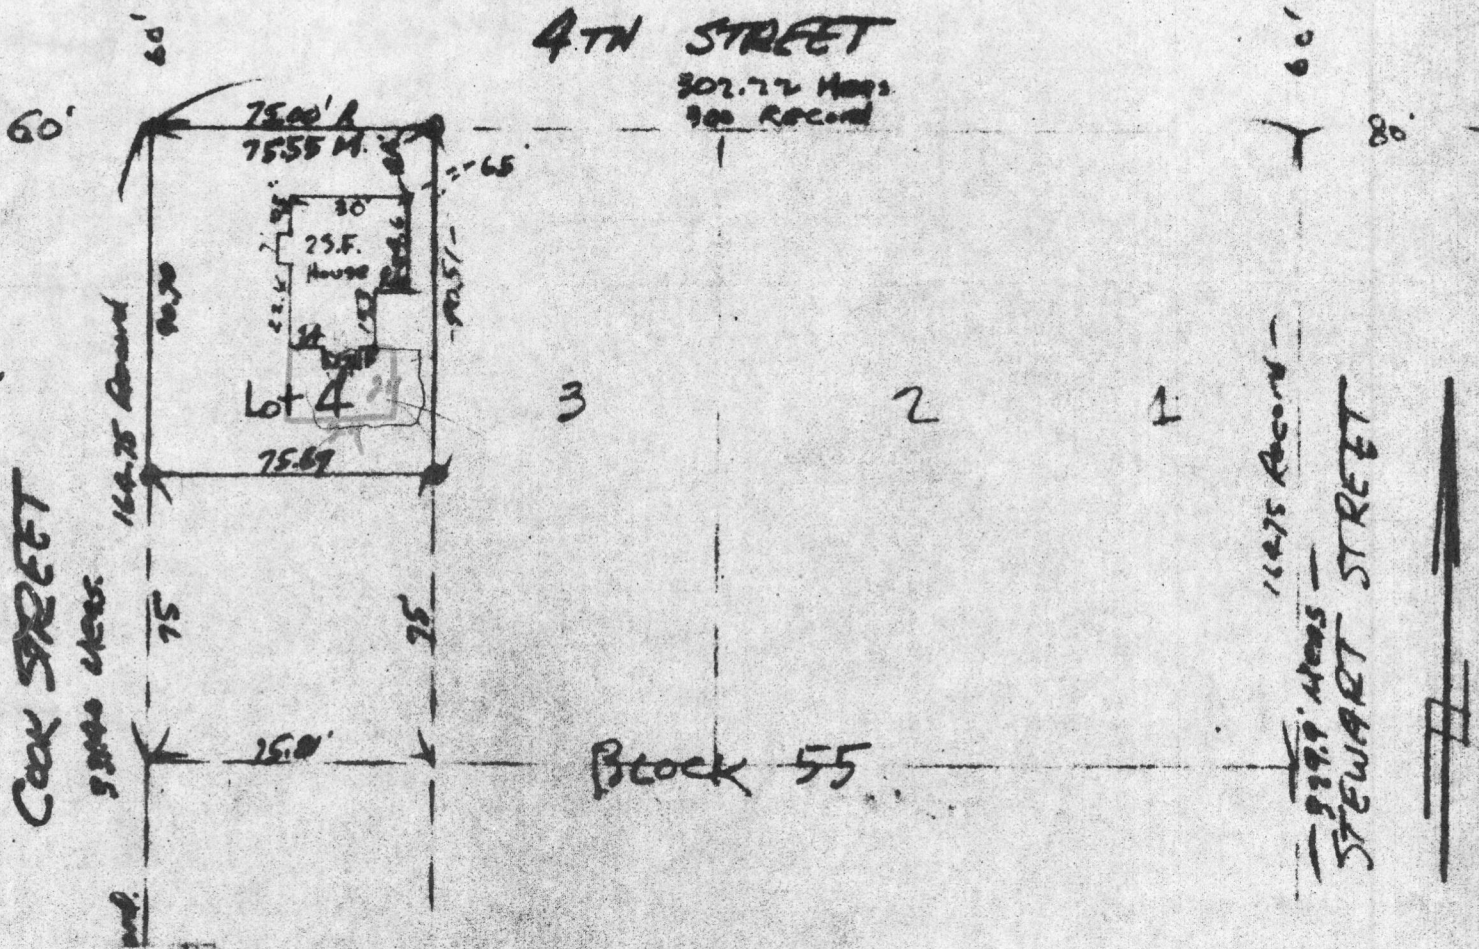

I hereby certify that location of
building is correct as shown.

July
1970

J. R. Hoffman

J. R. Hoffman, Surveyor
Minn. Reg. No. 1979