FROM THE OFFICE OF

CHARLES O. GEORGI COMPANY

2215 West County Road B — Saint Paul 8, Minnesota

MINNESOTA REGISTERED LAND SURVEYOR

Certificate of Survey

I Hereby Certify that this plat shows a survey made by me of the property described on this plat, and that the corners are correctly placed as shown, and that all locations, encroachments, etc., have been correctly shown. *No buildings are located within the 25' easement.*

Surveyed For WHIRLPOOL CORPORATION


Scale 1" = 50'

By Charles O. Georgi
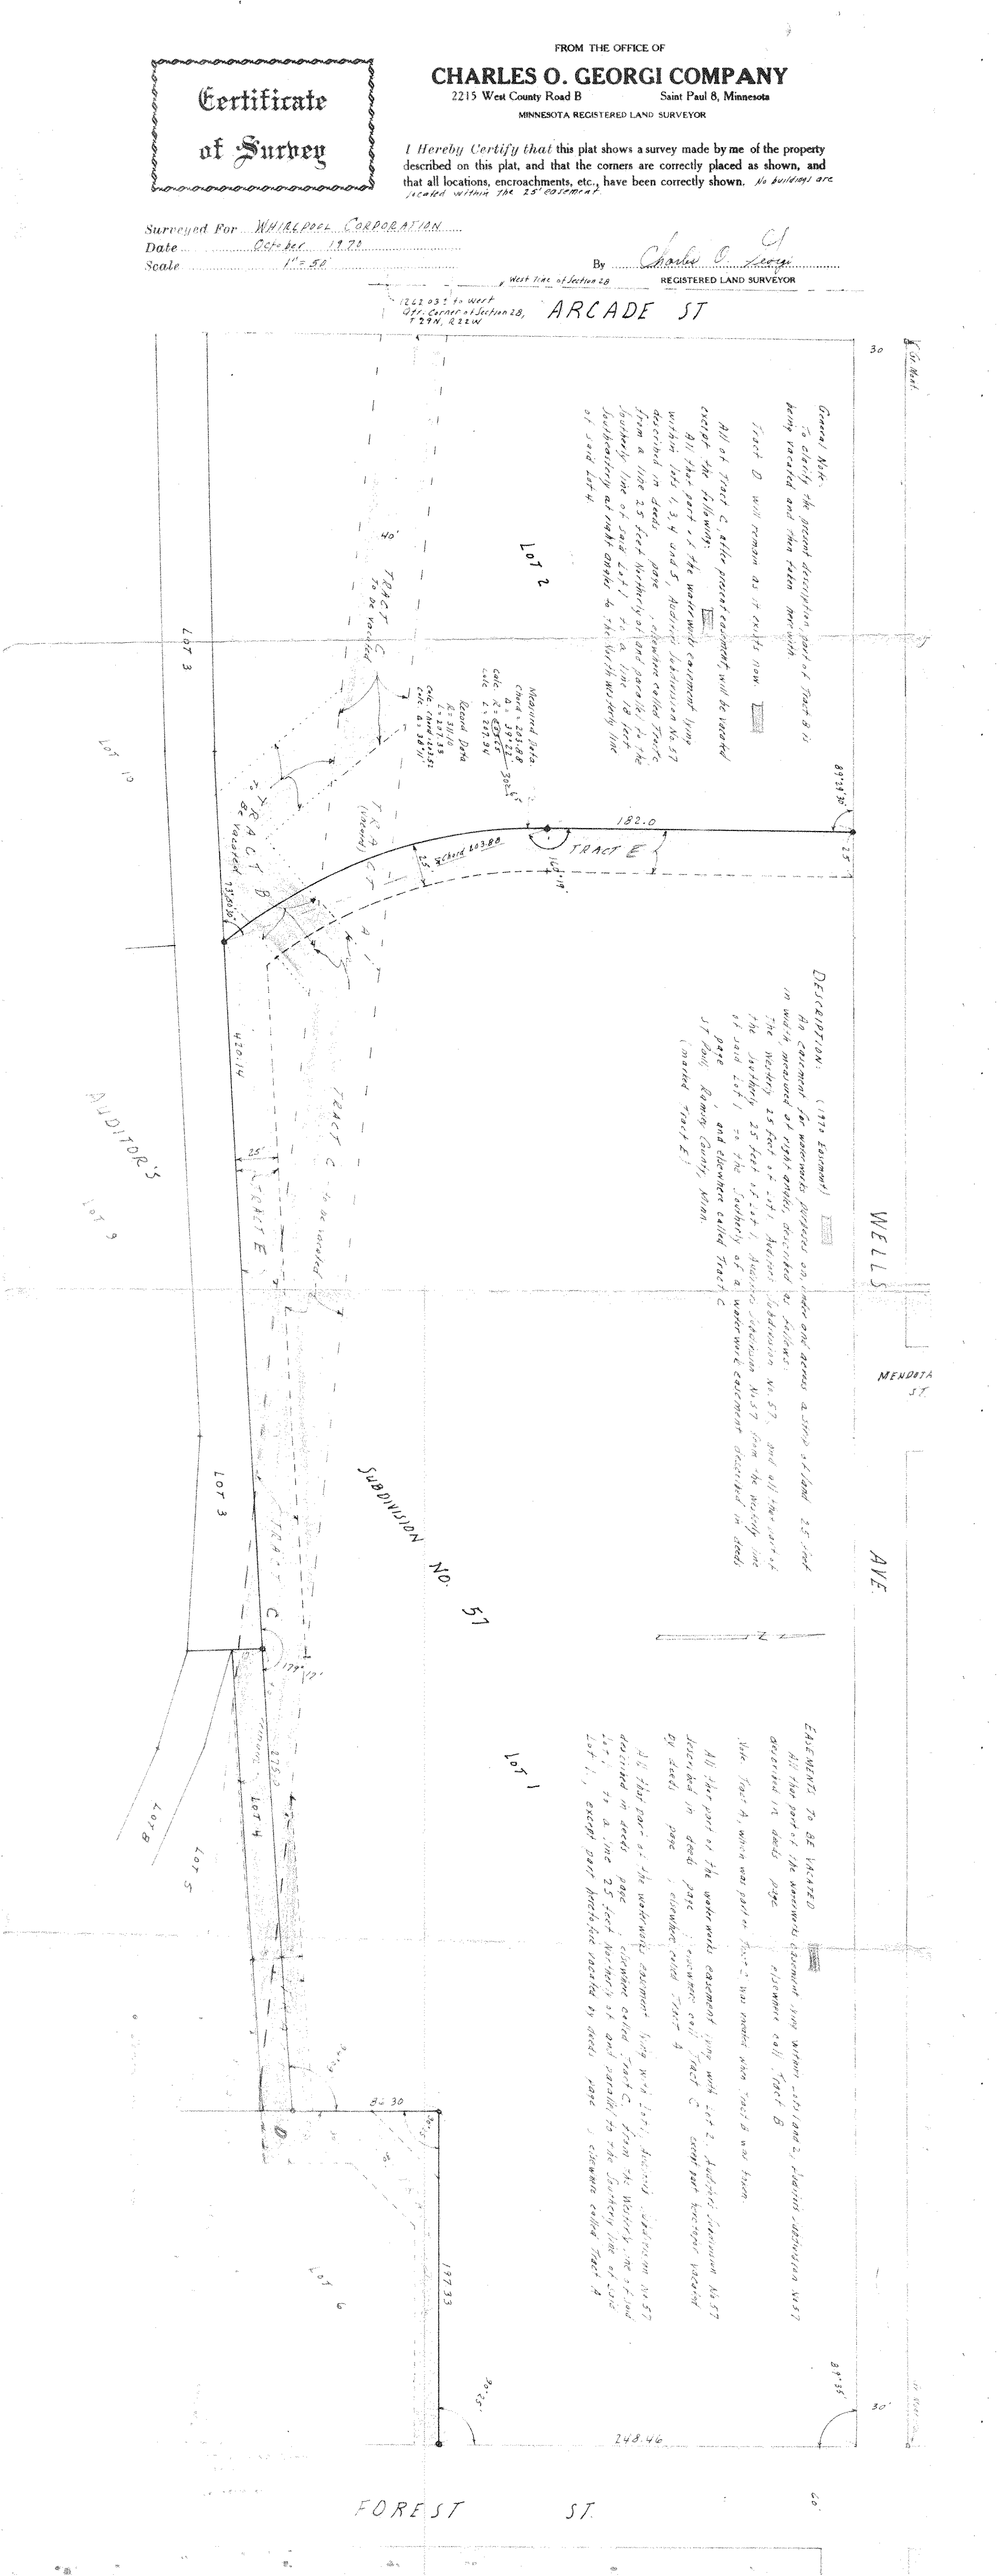
REGISTERED LAND SURVEYOR