NE 29 29 22

FROM THE OFFICE OF

# CHARLES O. GEORGI COMPANY

2215 West County Road B Saint Paul, Minnesota 55113

REGISTERED CIVIL ENGINEER AND LAND SURVEYOR

# Certificate of Survey

*I Hereby Certify that* this plat shows a survey made by me of the property described on this plat, and that the corners are correctly placed as shown, and that all locations have been correctly shown.

*Surveyed For* Hedvig N. Bystedt

*Date* September, 1970

*Scale* 1" = 40'

By Charles O. Georgi
REGISTERED LAND SURVEYOR

*Description:*
Lot 10,
Block 19,
Oakville Park, St. Paul,
Ramsey County, Minnesota.

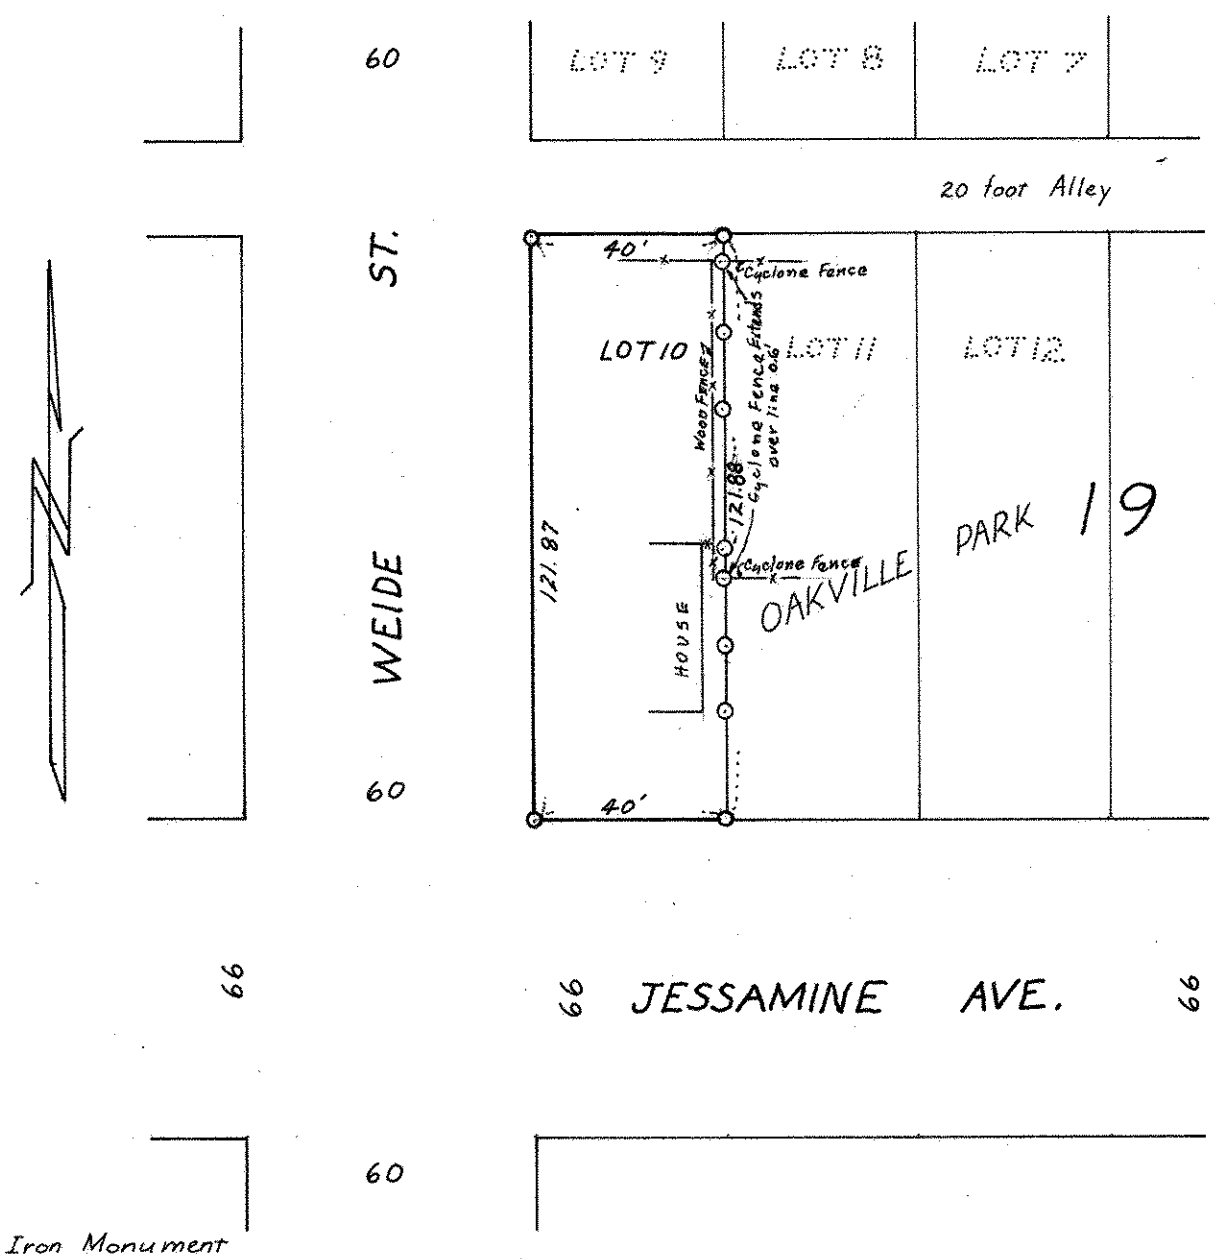


o Denotes Iron Monument