SW 22 29 22

FROM THE OFFICE OF

CHARLES O. GEORGI COMPANY

2215 West County Road B Saint Paul, Minnesota 55113

REGISTERED CIVIL ENGINEER AND LAND SURVEYOR

Certificate of Survey

I Hereby Certify that this plat shows a survey made by me of the property described on this plat, and that the corners are correctly placed as shown, and that all locations have been correctly shown.

Surveyed For Del Arrigoni

Date July 1970

Scale 1" = 30'

By Charles O. Georgi
REGISTERED LAND SURVEYOR

Description:

Lot 7, Block 6, Rogers and Hendricks' Acre Lots No 2
except the South 50.9 feet thereof,
except the East 170.7 feet thereof and
except the West 30 feet thereof for Winchell St.
St Paul, Ramsey County, Minn.

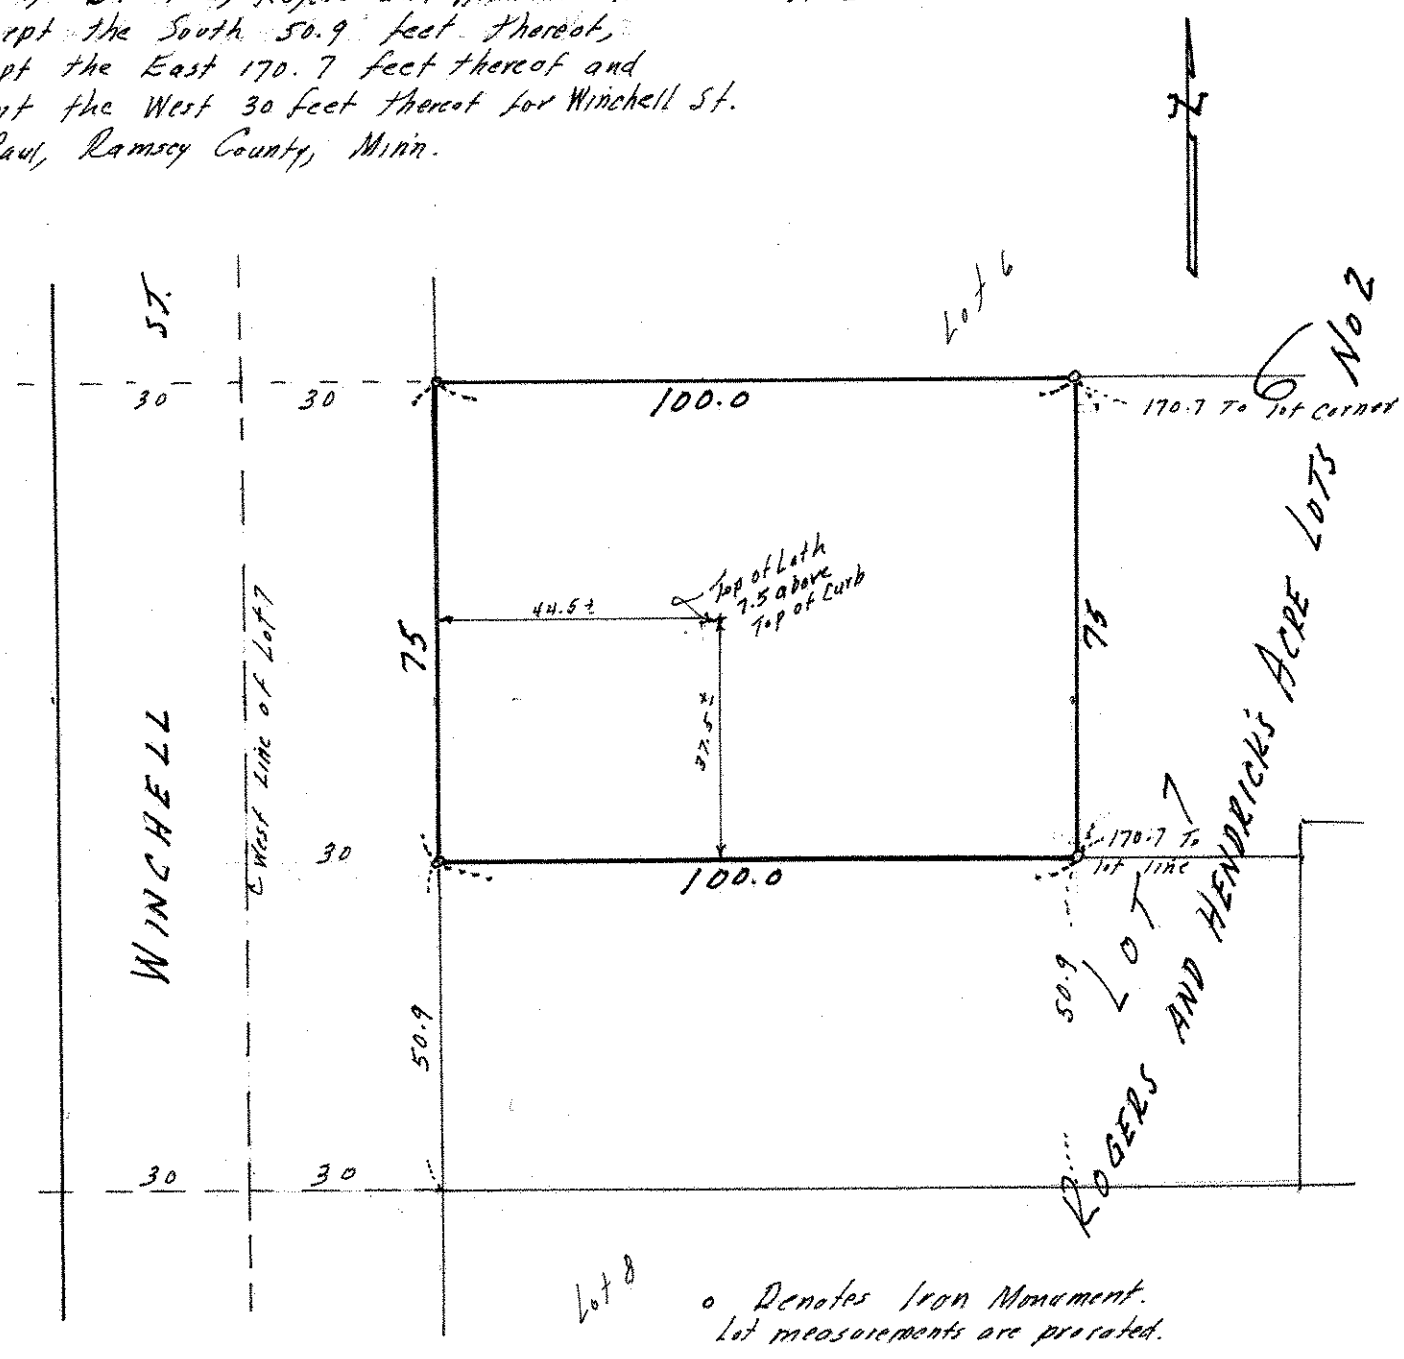

o Denotes Iron Monument.
Lot measurements are prorated.