


# PLAT OF SURVEY

OF PROPERTY OF Donald C. Erickson  
 DESCRIBED AS FOLLOWS Lots 14 and 15, Block 6, Burlington Heights  
Division No 1  
No 818 South Point Douglas Road, St. Paul, Minn.

SCALE: 1 INCH = 40 FEET

T. J. WELCH, REGISTERED SURVEYOR  
 701 EAST 3RD STREET, ST. PAUL, MINN. 55106

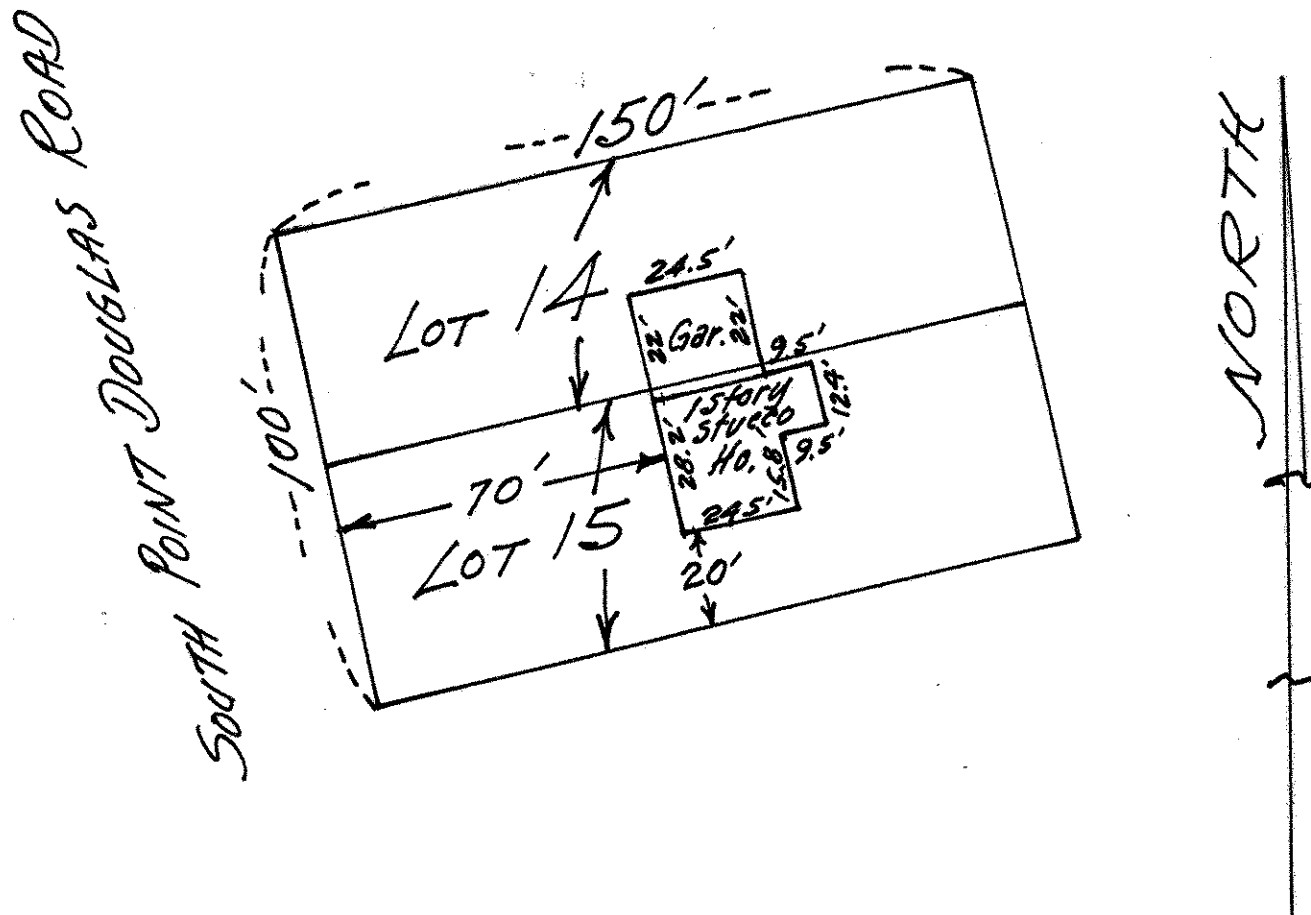

CERTIFICATE OF SURVEY

I hereby certify that on May 23 1970  
 I surveyed the property described above and that the above  
 plat is a correct representation of said survey.

J. J. Welch

*This survey is made exclusively for  
 First Federal Savings & Loan Assn. of  
 St. Paul. Lot lines are not guaranteed  
 as this is survey for mortgage purposes  
 only.*

342/15