NE 12 29 23

gave 4 copies with ~~Est~~ W - revised & other deleted

Certificate of Survey

FROM THE OFFICE OF

CHARLES O. GEORGI COMPANY

2215 West County Road B — Saint Paul, Minnesota 55113

REGISTERED CIVIL ENGINEER AND LAND SURVEYOR

I Hereby Certify that this plat shows a boundary and building location survey made by me on the property described on this plat, and that all locations, have been correctly shown. All corners are correctly placed as shown.

For: Roseville Baptist Church.

Date May 7, 1971

Scale 1" = 100 By Charles O. Georgi

REGISTERED LAND SURVEYOR

* Description:

The ~~East~~ 365 feet of the the ~~West~~ 3/4 of the South 635 feet of the SE 1/4 of the NE 1/4 of Section 12, T29N, R23W except that part thereof lying within the East 370 feet of the West 720 feet of the South 383 feet of the SE 1/4 of the NE 1/4 of said Section 12, Subject to County Road B²; and

All that part of the East 370 feet of the West 720 feet of the South 383 feet of the SE 1/4 of the NE 1/4 of Section 12, T29N, R23W lying within the ~~West~~ East 365 feet of the ~~East~~ West 3/4 of the SE 1/4 of the NE 1/4 of said Section 12, Subject to County Road B²

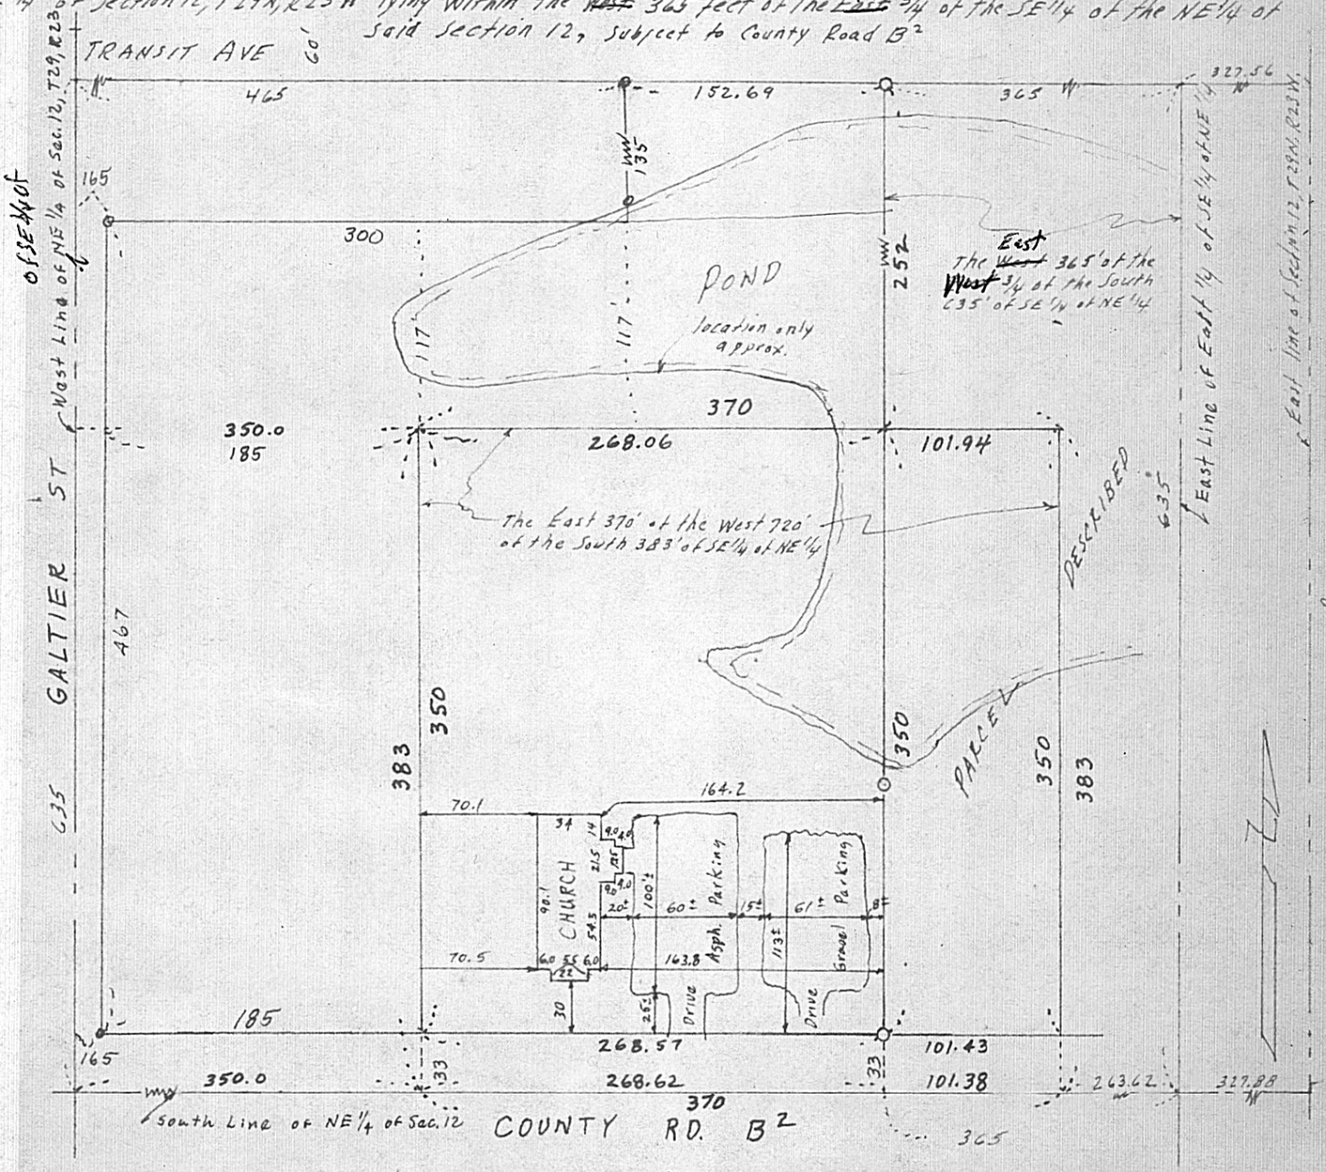

o Denotes Iron Monument

* General Note: Description written as requested because of two deeds.