

CHARLES O. GEORGI COMPANY

2215 West County Road B

Saint Paul, Minnesota 55113

REGISTERED CIVIL ENGINEER AND LAND SURVEYOR

Certificate of Survey

I Hereby Certify that this plat shows a lot survey made by me on the property described on this plat, and that all locations, have been correctly shown, and that the corners are correctly placed as shown.

Date April, 1971


Scale 1" = 40'

By *Charles O. Georgi*
REGISTERED LAND SURVEYOR

Equipment Supply Inc.

Description:

Lot 9, Block 2, Bakers Addition,
St. Paul, Ramsey County, Minnesota.

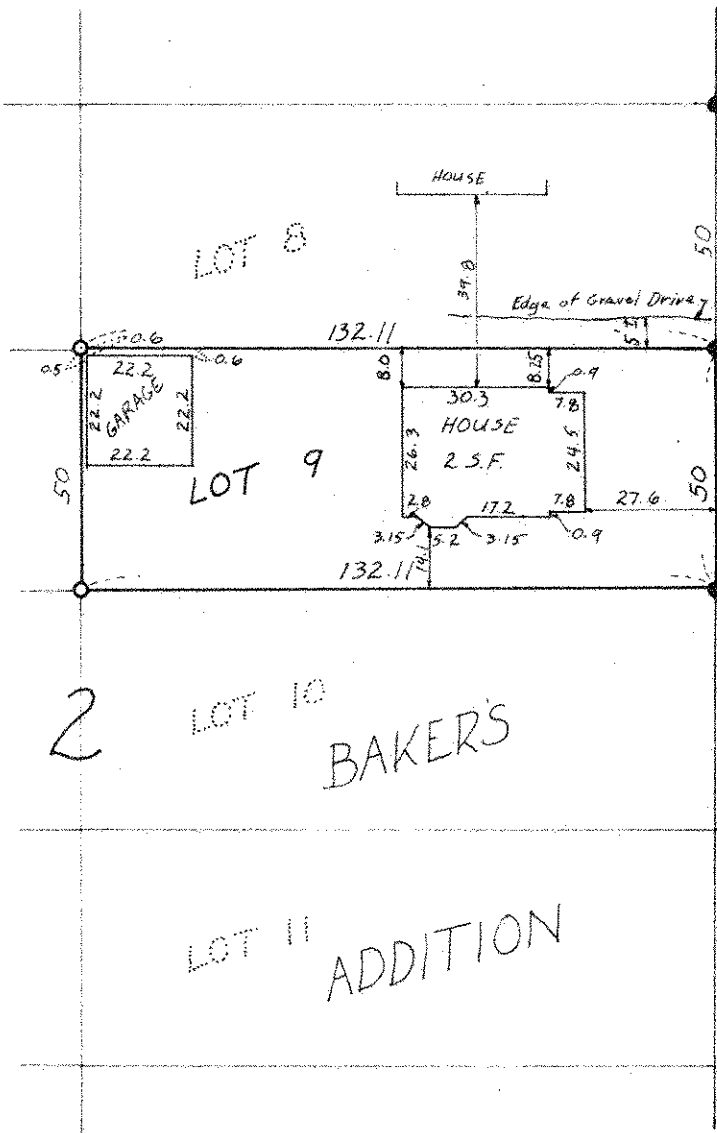

66

ST.

CURFEW

66



- Denotes Iron Pipe Monument
- Denotes Iron Pipe Monument