

FROM THE OFFICE OF

CHARLES O. GEORGI COMPANY

2215 West County Road B

Saint Paul, Minnesota 55113

REGISTERED CIVIL ENGINEER AND LAND SURVEYOR



Certificate of Survey

I Hereby Certify that this plat shows a survey made by me of the property described on this plat, and that the corners are correctly placed as shown, and that all locations have been correctly shown.

Surveyed For EDWARD CAPP

Date October 1971


Scale 1" = 60'

By Charles O. Georgi
REGISTERED LAND SURVEYOR

2030 Nebraska

Description:

The West 73.77 feet of the East 143.77 feet of Lot 6, Block 12,
Furness Garden Lots,
Ramsey County, Minnesota

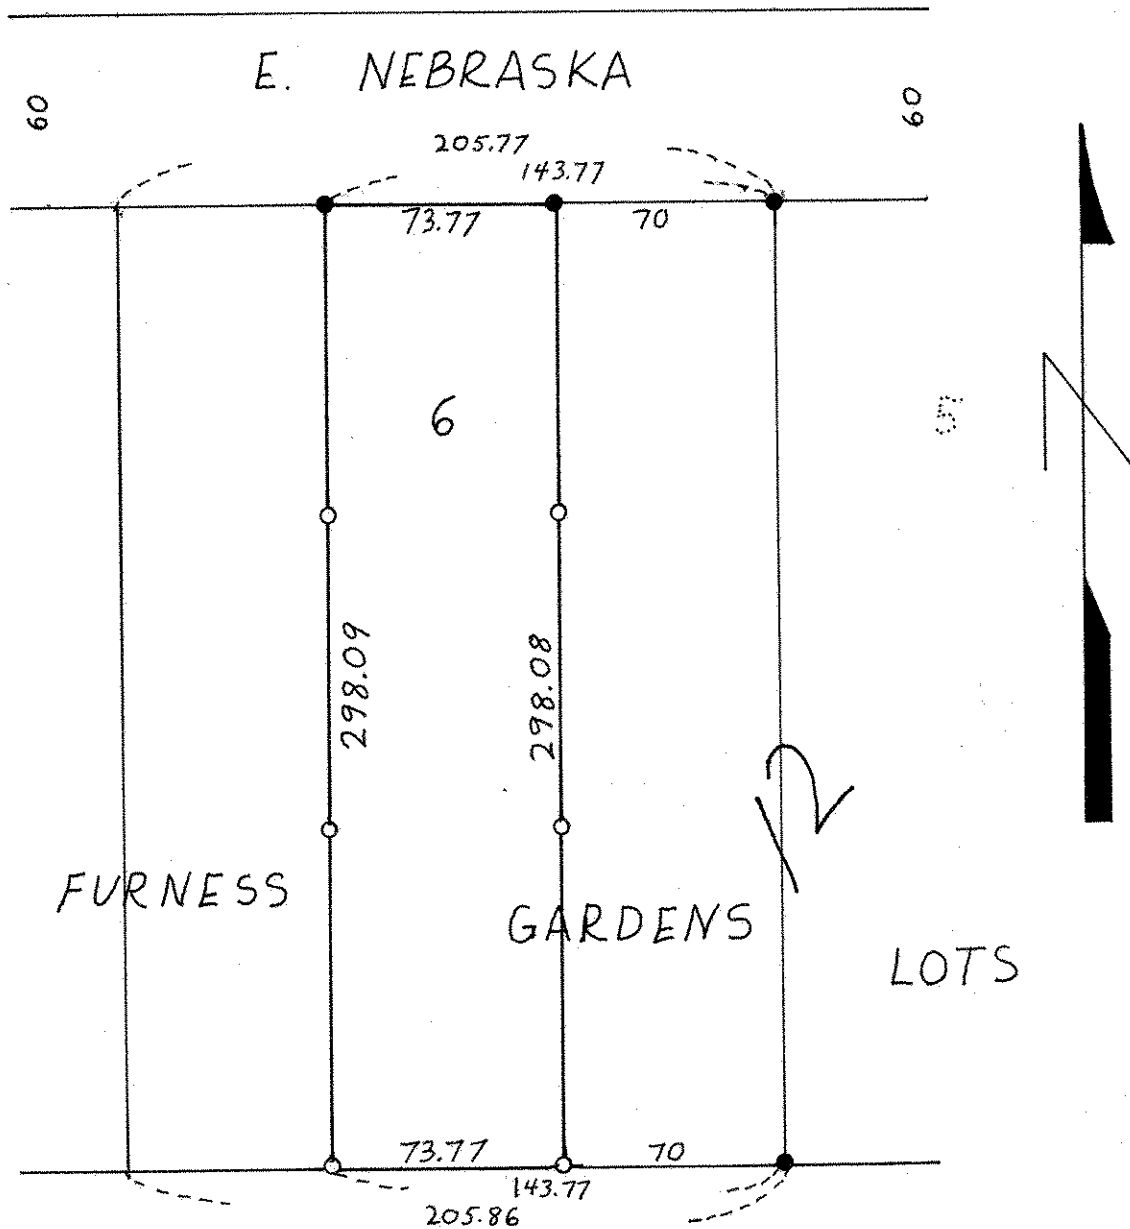

- Denotes Iron Pipe Monument
- Denotes Iron Pipe Monument Found in Place