FROM THE OFFICE OF

## Gertificate of Survey

## CHARLES O. GEORGI COMPANY

2215 West County Road B

Saint Paul, Minnesota 55113

REGISTERED CIVIL ENGINEER AND LAND SURVEYOR

I Hereby Certify that this plat shows a survey made by me of the property described on this plat, and that the corners are correctly placed as shown, and that all locations have been correctly shown.

Surveyed For F. J. Horner Co.


Date Angust 1971

Scale / "= 30'

By Charles O Leggi

Description:

Lot 12, Wilson Park, Ramsey County, Minn.

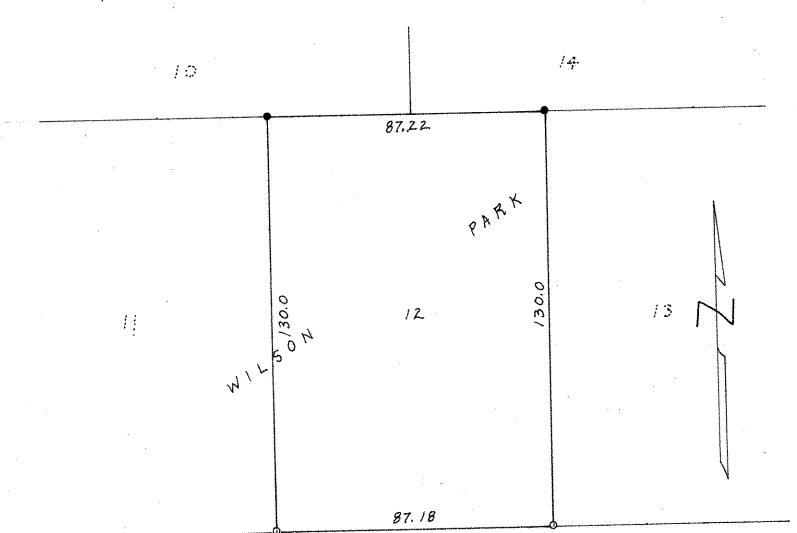

W,

ROSELAWN

o Denotes Iron Monument

AVE. • Denotes Iron found inplace