FROM THE OFFICE OF

Certificate of Survey

CHARLES O. GEORGI COMPANY

2215 West County Road B

Saint Paul, Minnesota 55113

REGISTERED CIVIL ENGINEER AND LAND SURVEYOR

I Hereby Certify that this plat shows a survey made by me of the property described on this plat, and that the corners are correctly placed as shown, and that all locations have been correctly shown.


Surveyed For F. J. Horner Co.

Date July, 1971

Scale 1"= 40'

By REGISTERED LAND SURVEYOR

Description: Lot 18, Tierney Park, Ramsey County, Minnesota.

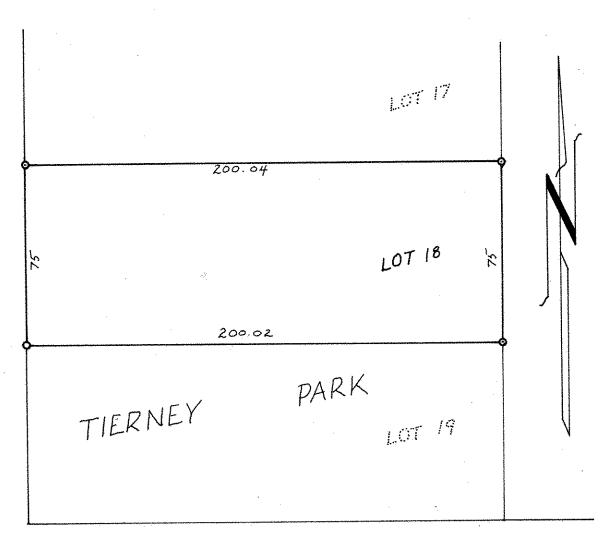

(Not graded)

3 TIERNEY AVE.

• Denotes Iron Pipe Monument

9