

FROM THE OFFICE OF

CHARLES O. GEORGI COMPANY

2215 West County Road B

Saint Paul, Minnesota 55113

REGISTERED CIVIL ENGINEER AND LAND SURVEYOR



Certificate of Survey

I Hereby Certify that this plat shows a survey made by me of the property described on this plat, and that the corners are correctly placed as shown, and that all locations have been correctly shown.

4/17/79 Located Irons For Vince Hencier

Surveyed For Katherine Dallas


Date June, 1971

Scale 1" = 40'

By Charles O. Georgi
REGISTERED LAND SURVEYOR

Description:

Lots 4, 5, 6, and 7, Block 4,
Lexington Park Plat II, and
the East 1/2 of the adjoining
vacated alley,
Ramsey County,
Minnesota.

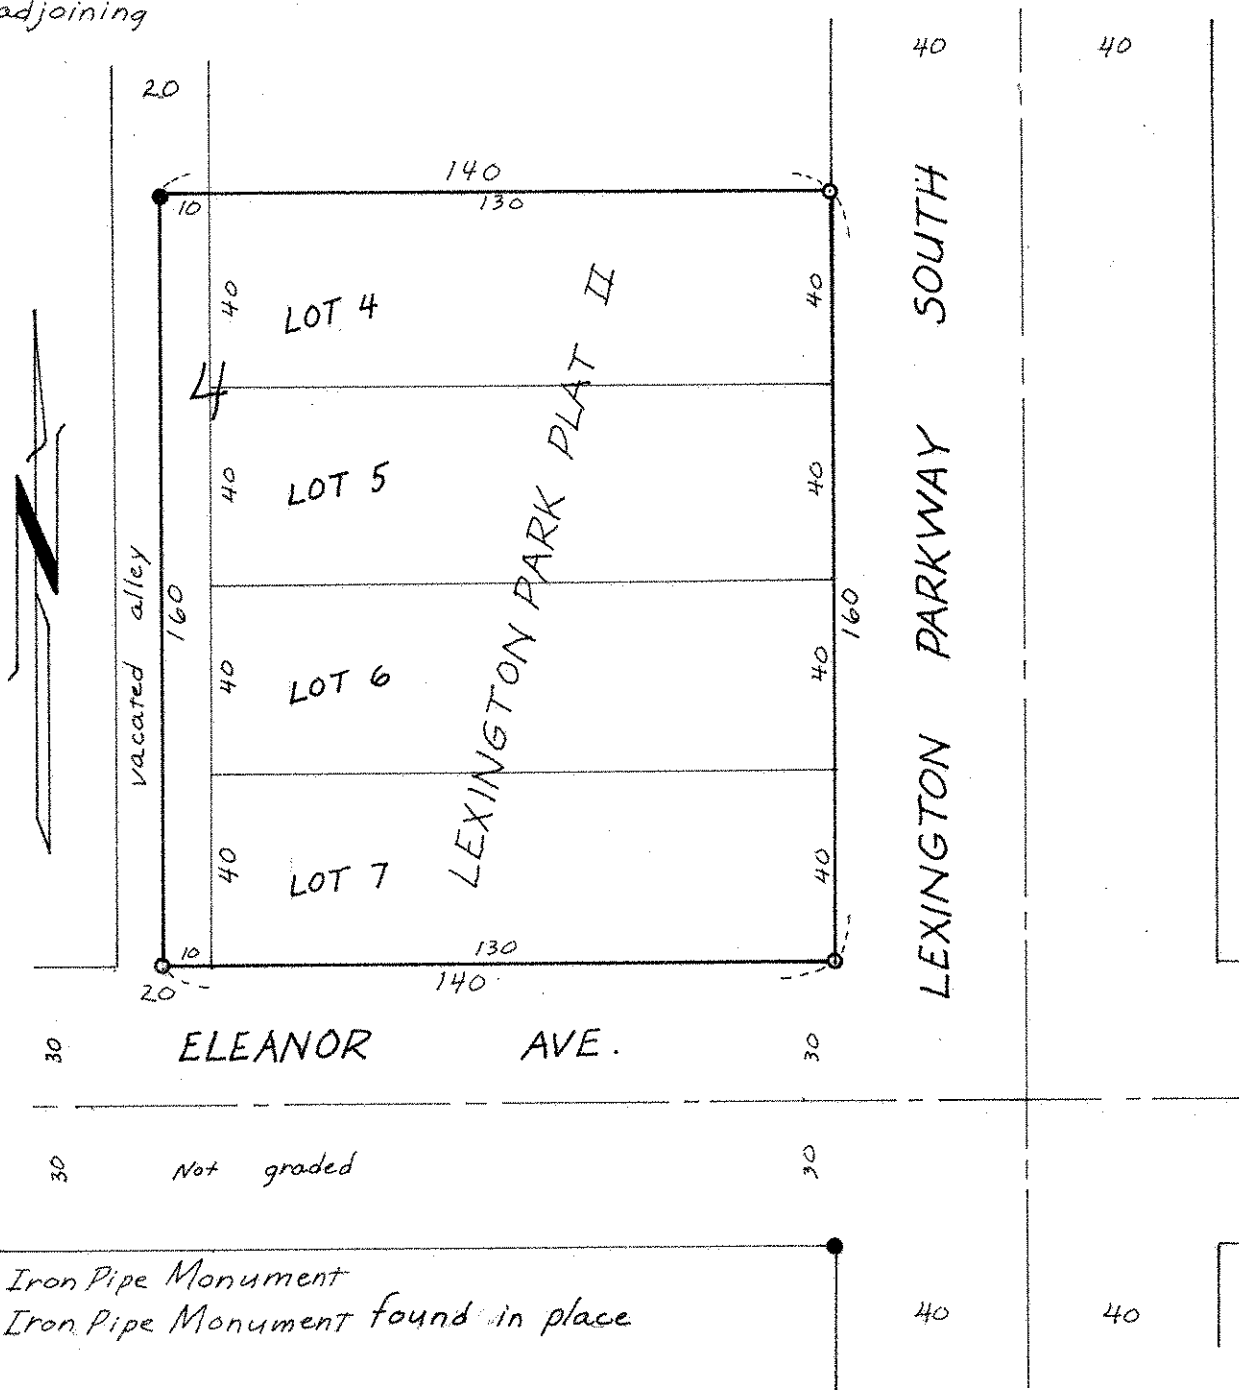

- Denotes Iron Pipe Monument
- Denotes Iron Pipe Monument found in place