

FROM THE OFFICE OF

CHARLES O. GEORGI COMPANY

2215 West County Road B

Saint Paul, Minnesota 55113

REGISTERED CIVIL ENGINEER AND LAND SURVEYOR

Certificate of Survey

I Hereby Certify that this plat shows a survey made by me of the property described on this plat, and that the corners are correctly placed as shown, and that all locations have been correctly shown.

Surveyed For Dahn Const. Co.


Date August, 1971

Scale 1" = 40'

By Charles O. Georgi
REGISTERED LAND SURVEYOR

Description:

Lots 16, 17, and 18, and the Easterly 1/2 of the vacated alley adjacent to said lots, and the East 15 feet of lots 7, 8, and 9, and the Westerly 1/2 of the vacated alley adjacent to said lots, all in Block 46, Desnoyer Park, Ramsey County, Minnesota.

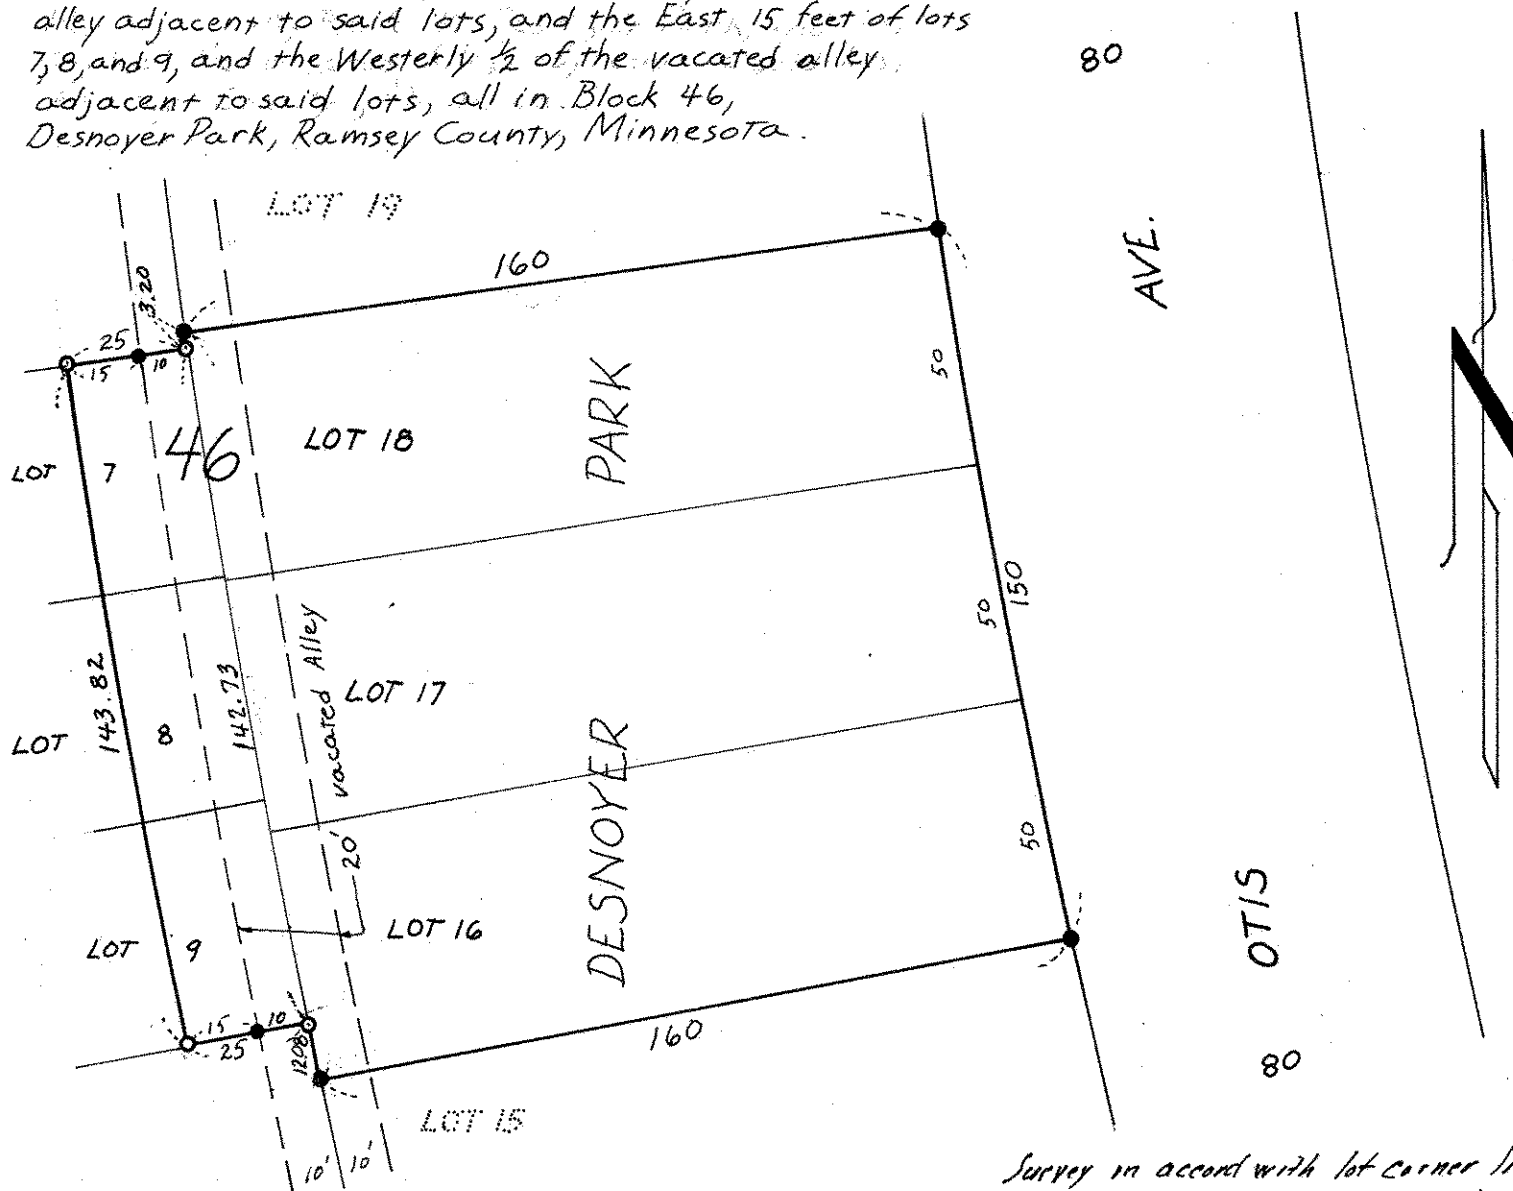

Survey in accord with lot corner irons in place and lines of occupancy in this block.

- Denotes Iron Pipe Monument
- Denotes Iron Pipe Monument