Gertificate

CHARLES O. GEORGI COMPA

2215 West County Road B

Saint Paul, Minnesota 55113

REGISTERED CIVIL ENGINEER AND LAND SURVEYOR

I Hereby Certify that this plat shows a survey made by me of the property described on this plat, and that the corners are correctly placed as shown, and that all locations have been correctly shown.


Surveyed For Robert White - Church of Christ Date November 1972 Scale /"= 50

Description:

The West 1/2 of SW1/t of SE1/t of SE1/t of Section 13, T29N, R 23 W, except the North 428.58 feet thereof according to Gov't Survey thereof. Subject to Larpenteur Ave. (County Road A), and Marion St. for public road purposes and subject to an easement for snow fences, Book 1212 page 9/1 and Book 1330 of deed 499 granted to Village of Roseville, and subject to Village sewer easement 395046.

Ramsey County, Minnesota

1000 17358

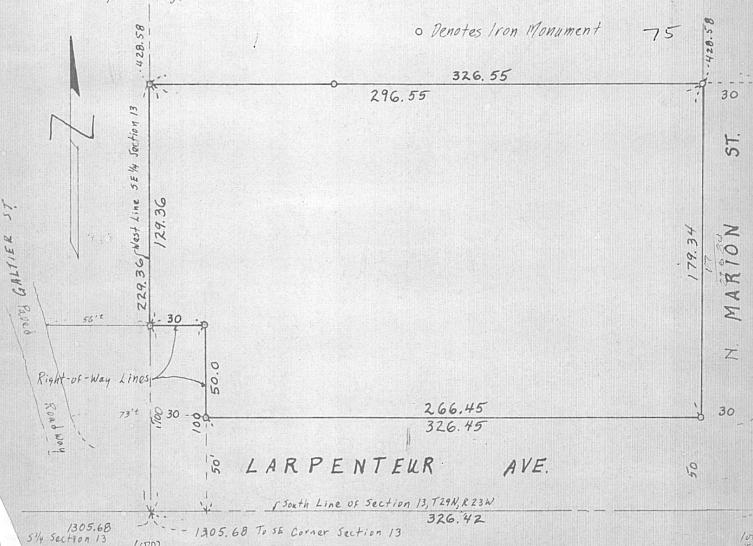

1305.68 To SE Corner Section 13

Northerly Extension of West Line of Block 4, Rich St. Villas