SE 28 30 22

Certificate of Survey

FROM THE OFFICE OF

CHARLES O. GEORGI COMPANY

2215 West County Road B — Saint Paul, Minnesota 55113

REGISTERED CIVIL ENGINEER AND LAND SURVEYOR

I Hereby Certify that this plat shows a survey made by me of the property described on this plat, and that the corners are correctly placed as shown, and that all locations have been correctly shown.

Add 3/24/72 – SE 1/4

Surveyed For Finneman Enterprises Inc.

Date February 1972

Scale 1" = 60'

By Charles O. Georgi
REGISTERED LAND SURVEYOR

Description:

The East 130.81 feet of the West 1085.0 feet of the South 333.0 feet of the South 1/2 of South 1/2 of Section 28, T30N, R22W, Subject to County Road E.
Contains 1.0 acres, more or less
Ramsey County, Minnesota

SE 1/4

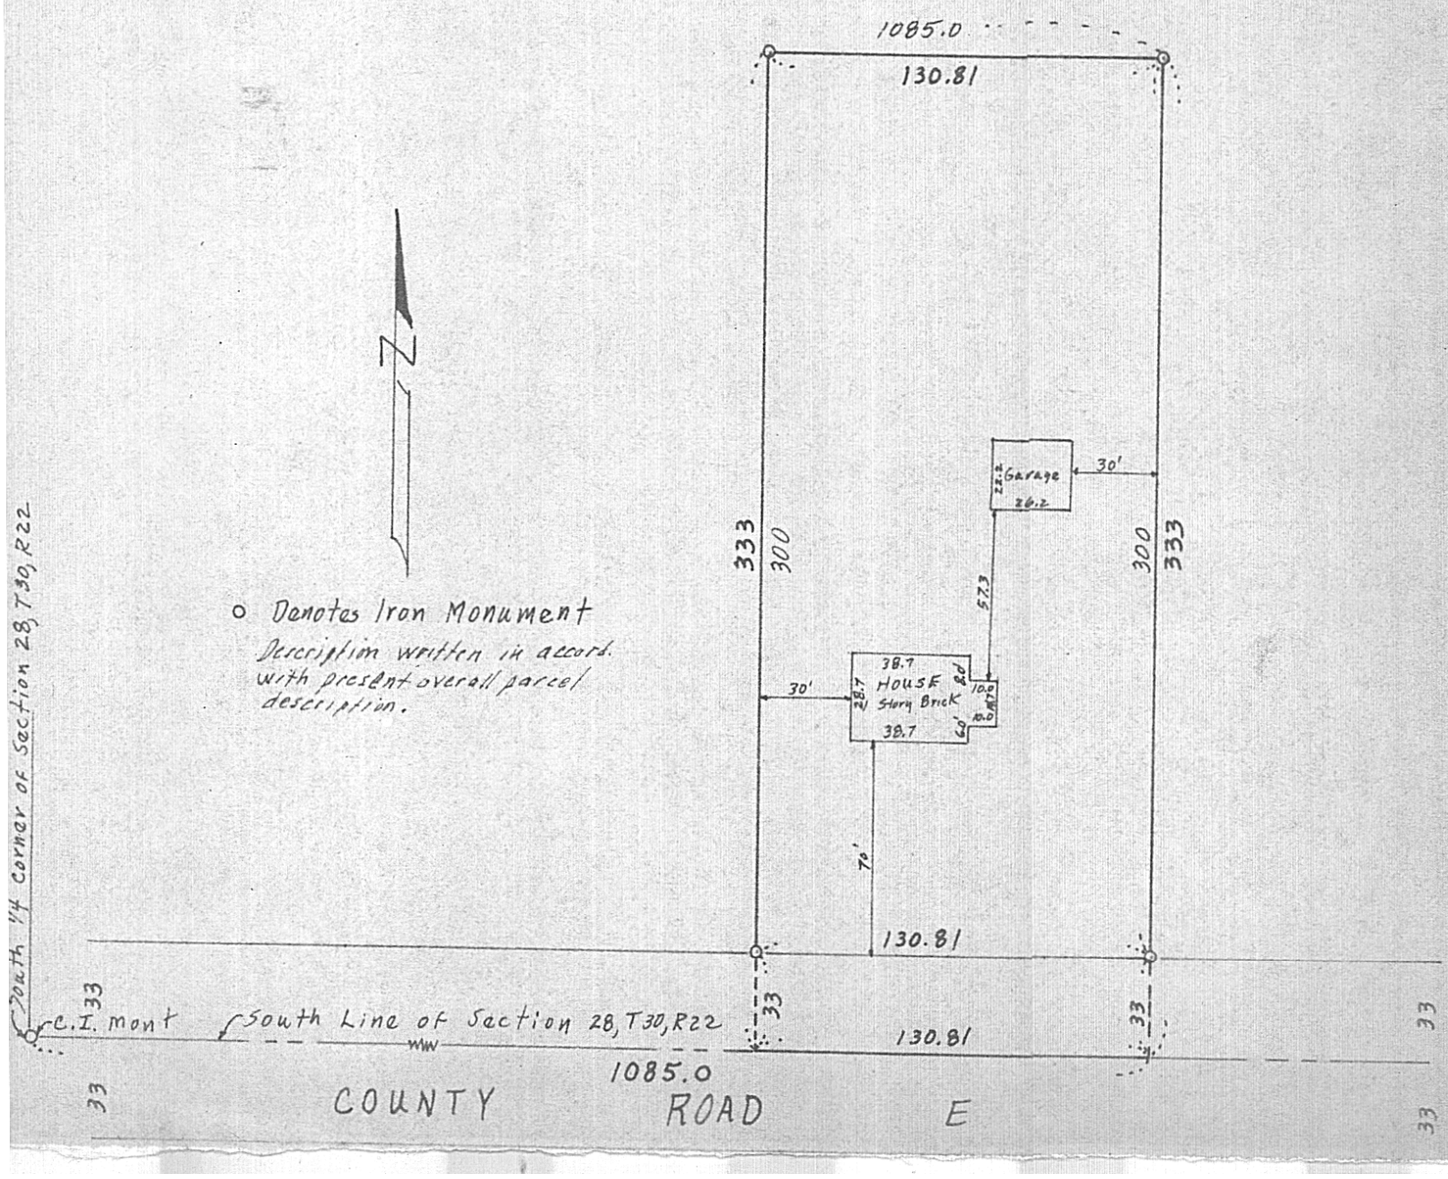

o Denotes Iron Monument

Description written in accord. with present overall parcel description.