

FROM THE OFFICE OF

CHARLES O. GEORGI COMPANY

2215 West County Road B

Saint Paul, Minnesota 55113

REGISTERED CIVIL ENGINEER AND LAND SURVEYOR

Certificate of Survey

I Hereby Certify that this plat shows a survey made by me of the property described on this plat, and that the corners are correctly placed as shown, and that all locations have been correctly shown.

Surveyed For *Michela Genst*.....

Date *June 1972*.....

Scale *1" = 30'*.....

By *Charles O. Georgi*
REGISTERED LAND SURVEYOR

Description:


Lot 5, Block 9,
Sunset Park,
Ramsey County, Minn.

LEXINGTON AVE.

center line

49.5'

49.5'

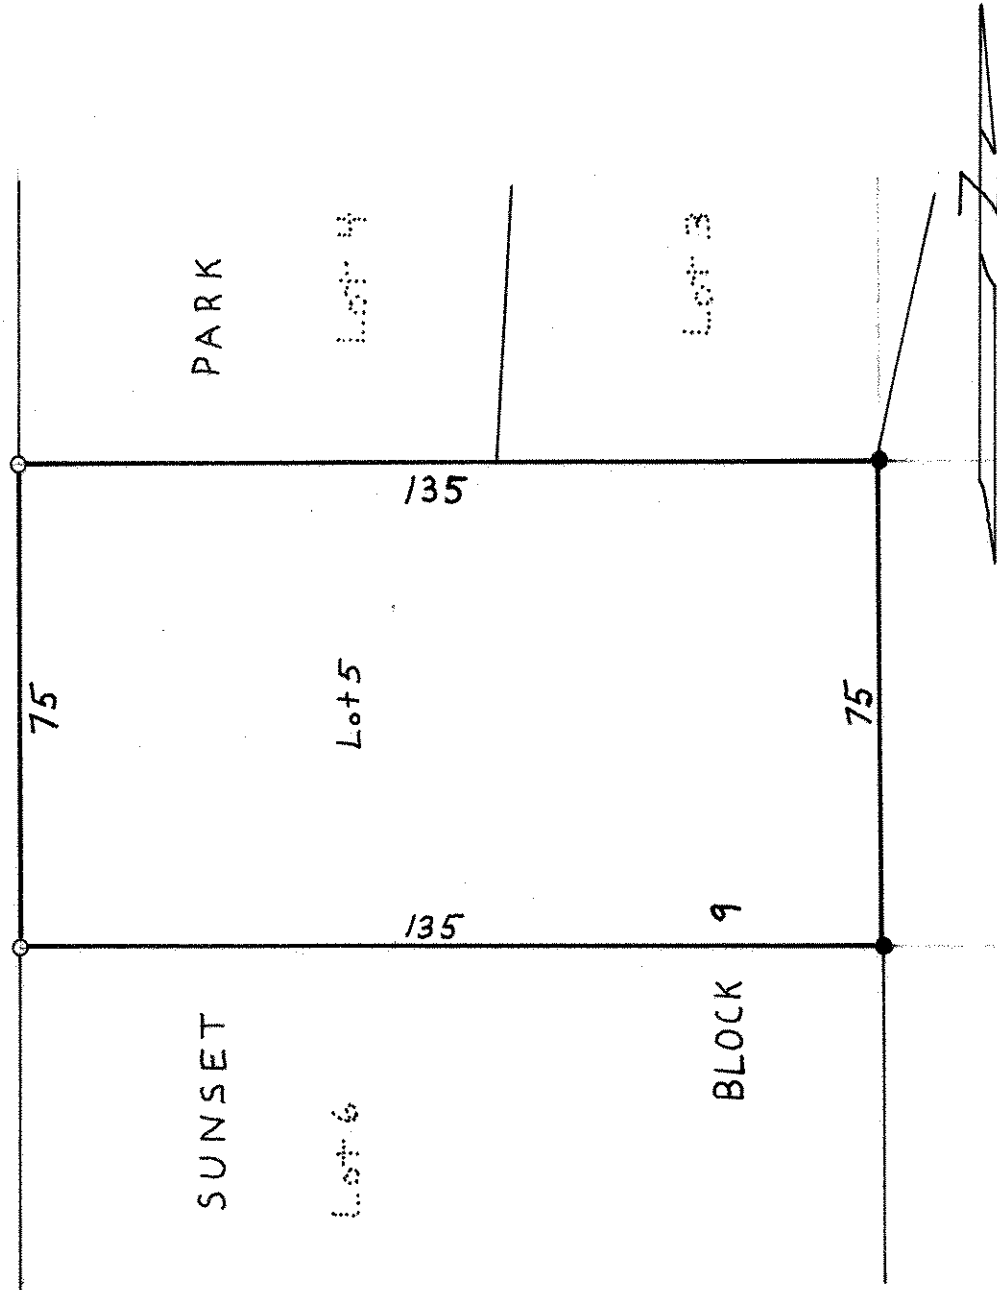

○ Denotes Iron Pipe Monument
● Denotes Iron Pipe Monument Found In Place