

N.W. 143023

FROM THE OFFICE OF

# CHARLES O. GEORGI COMPANY

2215 West County Road B

Saint Paul, Minnesota 55113

REGISTERED CIVIL ENGINEER AND LAND SURVEYOR

## Certificate of Survey

I Hereby Certify that this plat shows a survey made by me of the property described on this plat, and that the corners are correctly placed as shown, and that all locations have been correctly shown.

Surveyed For *Pinney-Michels Const.* (TURTLE LAKE)


Date *October 1972*

Scale *1"=50'*

By *Charles O. Georgi*  
REGISTERED LAND SURVEYOR

**Description:**

Lot 10, Oak Ridge,  
Ramsey County, Minnesota.

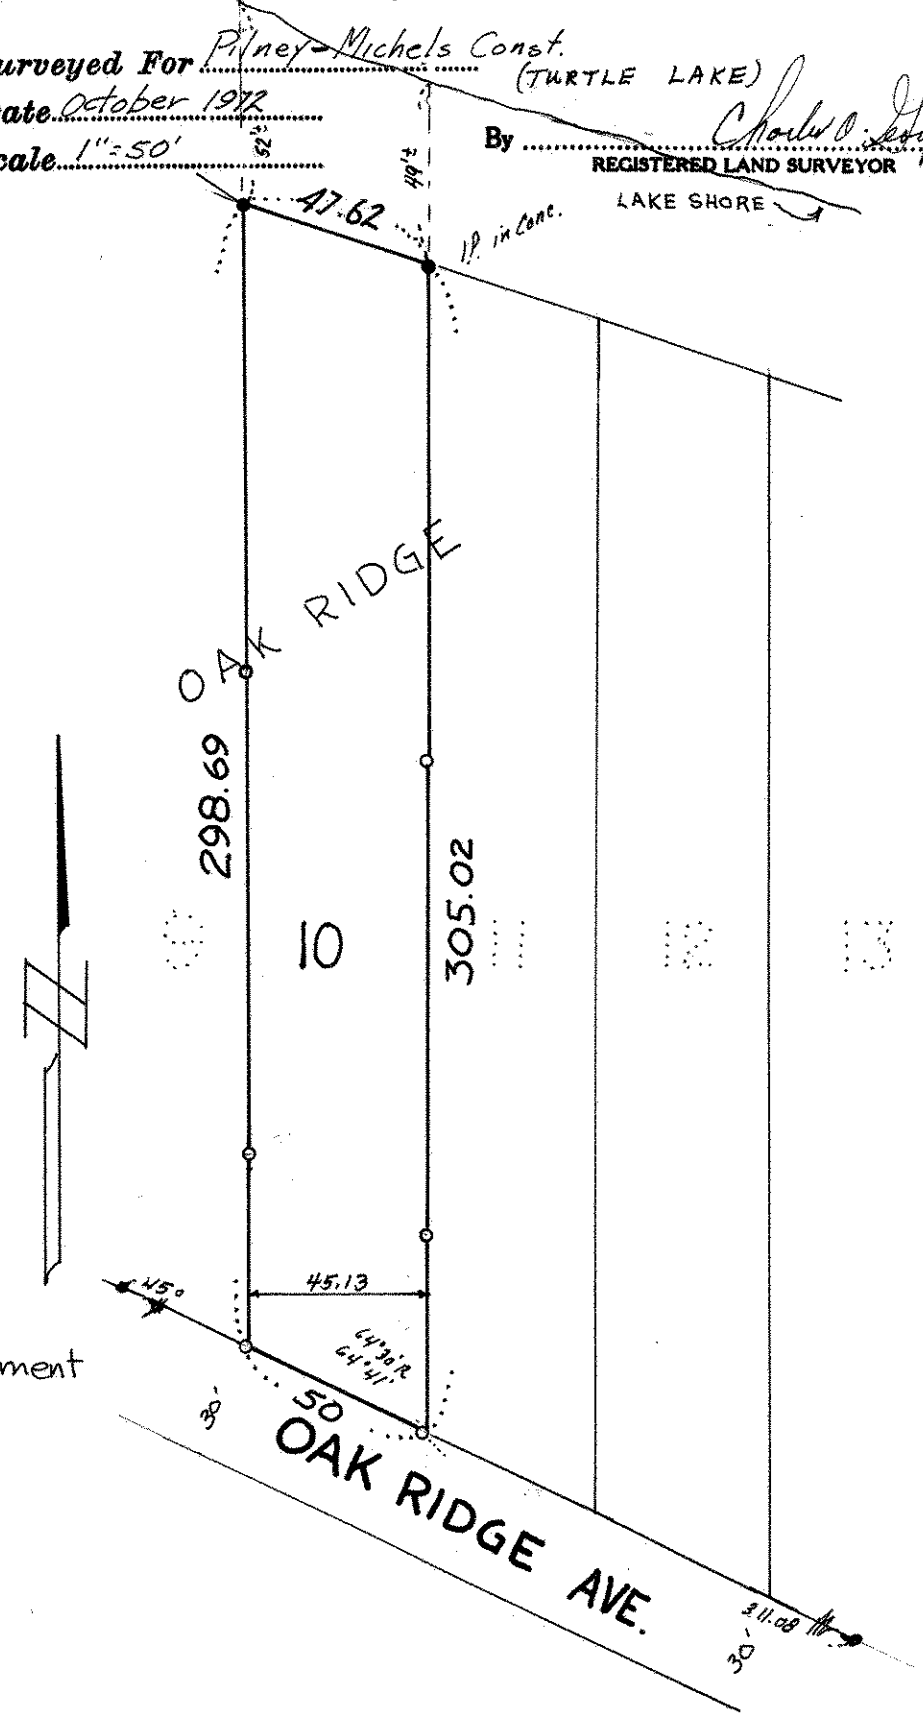

- o Denotes iron pipe monument
- Denotes Iron Found in place