FROM THE OFFICE OF

Certificate of Survey

CHARLES O. GEORGI COMPANY

2215 West County Road B

Saint Paul, Minnesota 55113

REGISTERED CIVIL ENGINEER AND LAND SURVEYOR

I Hereby Certify that this plat shows a survey made by me of the property described on this plat, and that the corners are correctly placed as shown, and that all locations have been correctly shown.

Surveyed For Clyde Rehbein-Northway Const.


Date July 1972

Scale | "=40'

RECISTERED LAND SUBVEYOR

Description:

Lot 12, Block 4, Brennan's Turtle Lake Park Subject to easement of record Ramsey county Minnesota.

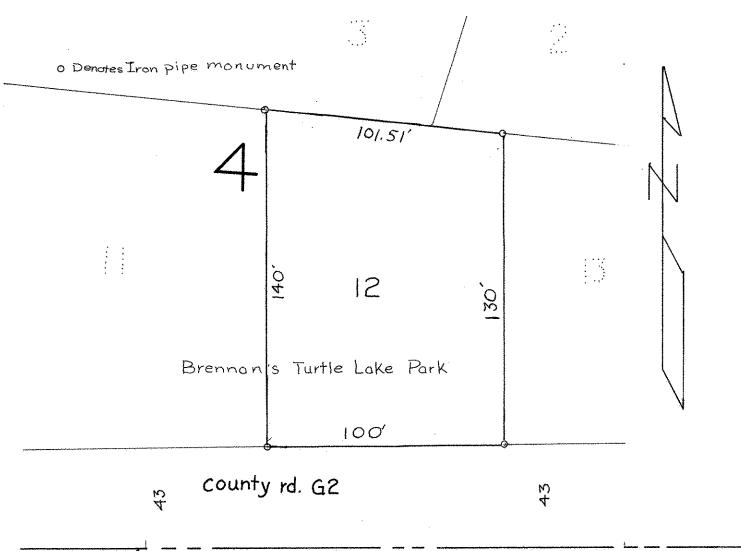

South Line of Northwest Quorter of Section 14, T30, R23.