SE 11 30 22

FROM THE OFFICE OF

CHARLES O. GEORGI COMPANY

2215 West County Road B Saint Paul, Minnesota 55113

REGISTERED CIVIL ENGINEER AND LAND SURVEYOR

Certificate of Survey

I Hereby Certify that this plat shows a survey made by me of the property described on this plat, and that the corners are correctly placed as shown, and that all locations have been correctly shown.

Surveyed For Gale Plastad Newell Nelson Dunn & Stringer Realtor

Date October 1972

Scale 1" = 60'

By Charles O. Georgi
REGISTERED LAND SURVEYOR

Description:

Lot 16 and the East 50 feet of the West 130 feet of Lots 18, and 19, Block 10, Bald Eagle.
(Town of Bald Eagle)

Ramsey County, Minnesota

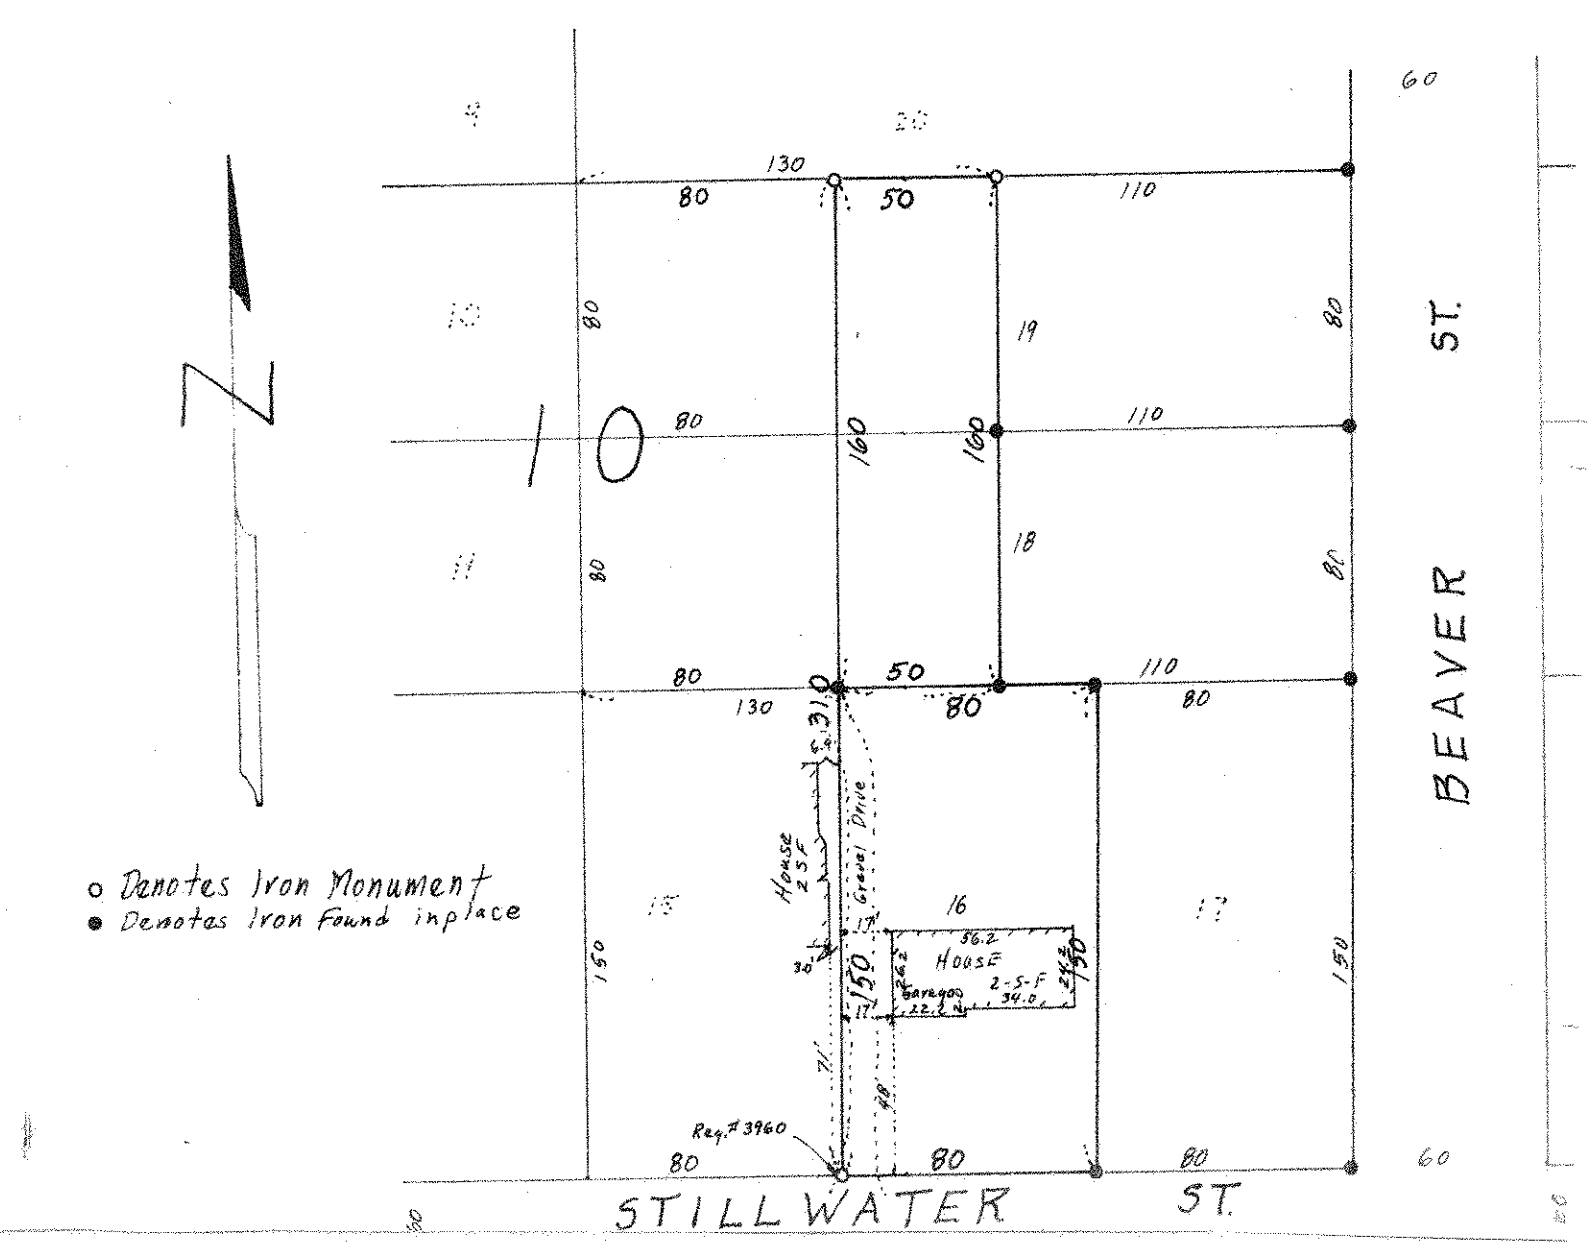
N
10
130
80
50
110
19
18
160
160
80
80
80