NW 30,29,22

FROM THE OFFICE OF

CHARLES O. GEORGI COMPANY

2215 West County Road B Saint Paul, Minnesota 55113

REGISTERED CIVIL ENGINEER AND LAND SURVEYOR

Certificate of Survey

I Hereby Certify that **this plat shows a survey made by me of the property described on this plat, and that the corners are correctly placed as shown, and that all locations have been correctly shown.**

Surveyed For Roy Spannous

Date SEPTEMBER 1972

Scale 1"=40'

By Charles O. Georgi
REGISTERED LAND SURVEYOR

Description:

Lot 30 and the East ½ of Lot 29, Block 2, Pottgieser's Sub., Ramsey County, Minnesota

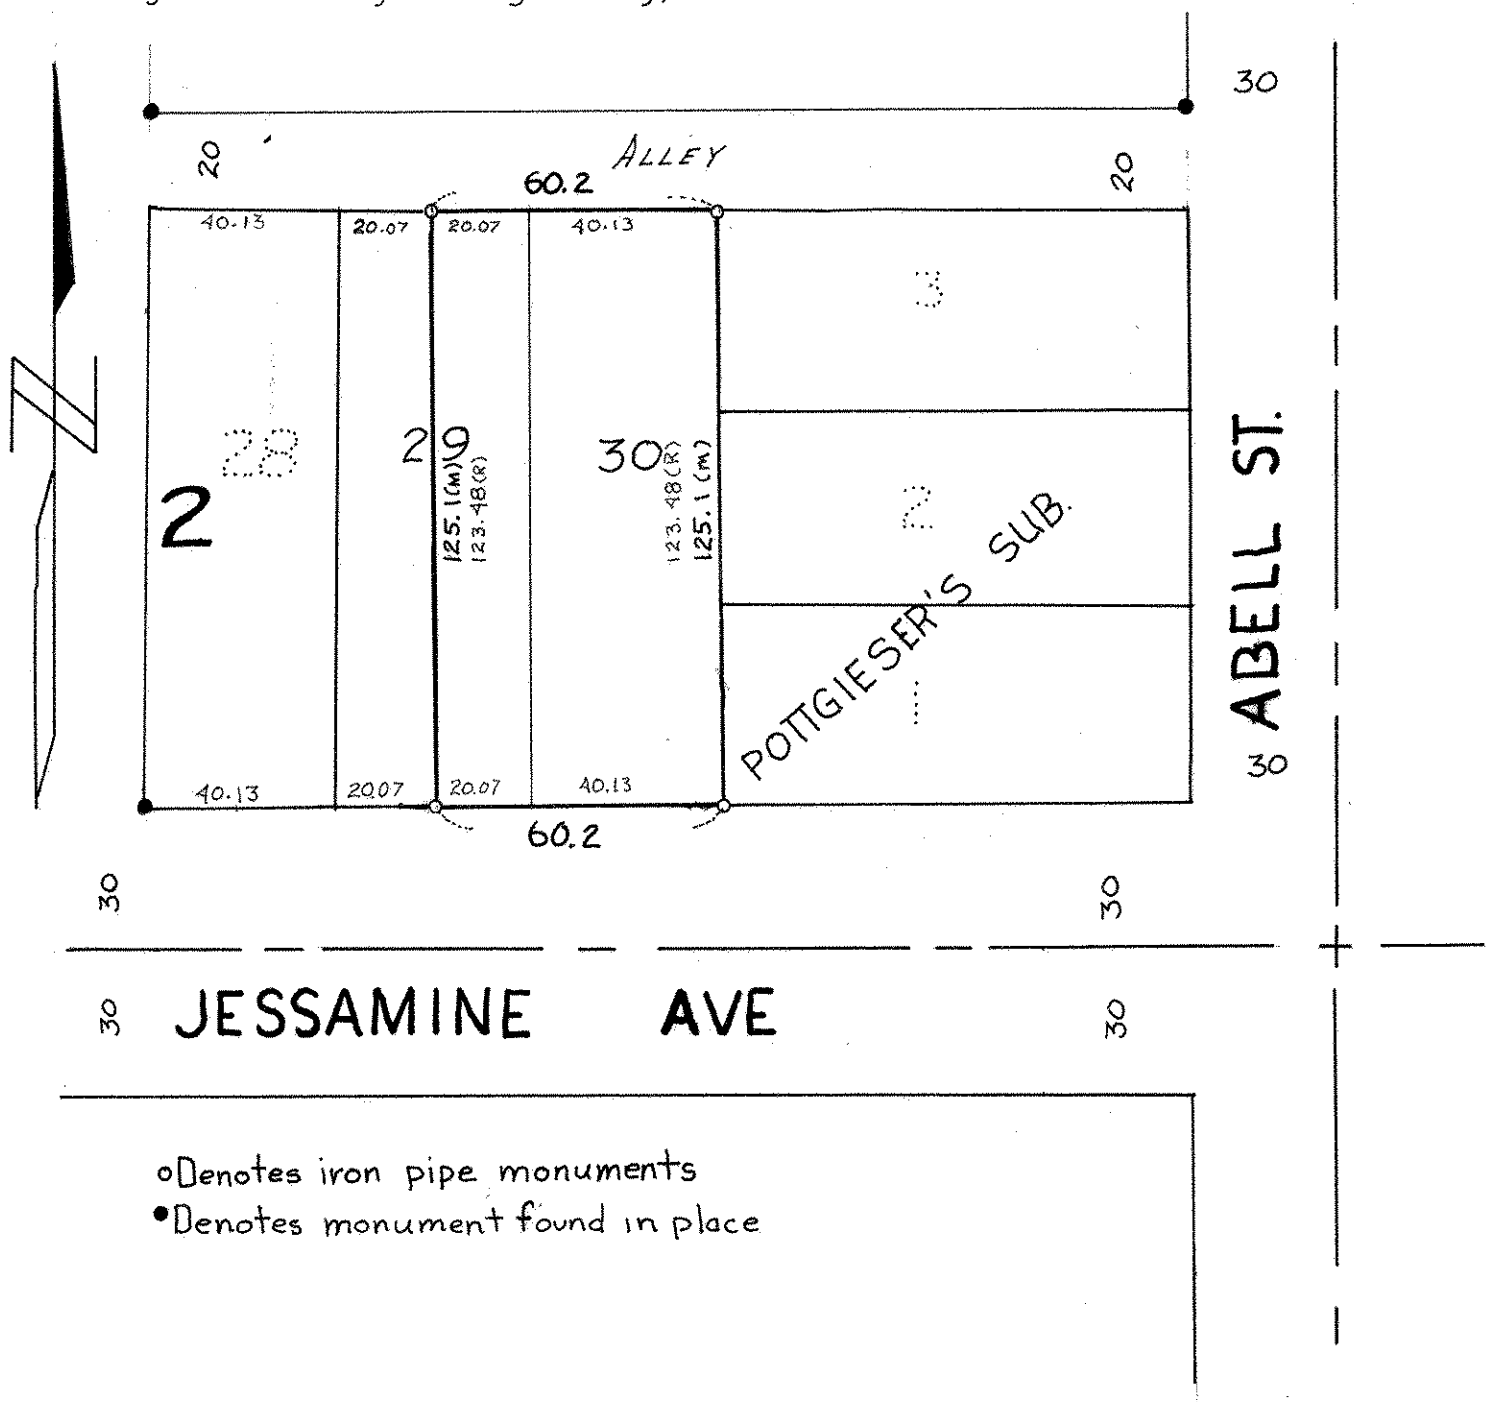

o Denotes iron pipe monuments

• Denotes monument found in place