SE 36 29 23

FROM THE OFFICE OF

CHARLES O. GEORGI COMPANY

2215 West County Road B Saint Paul, Minnesota 55113

REGISTERED CIVIL ENGINEER AND LAND SURVEYOR

Certificate of Survey

I Hereby Certify that this plat shows a building location survey made by me on the property described on this plat, and that all locations, have been correctly shown. 3/22/72 added note on width to Lot 7

Date February 1972

Scale 1" = 50'

By Charles O. Georgi
REGISTERED LAND SURVEYOR

Capitol View Nursing Home

Vincent P. Courtney, Attorney

Description:

The East 33 feet of Lot 7, and
all of Lots 8, 9, and 10,
Block 4,
ELFELT BERNHEIMER & ARNOLD'S ADDITION

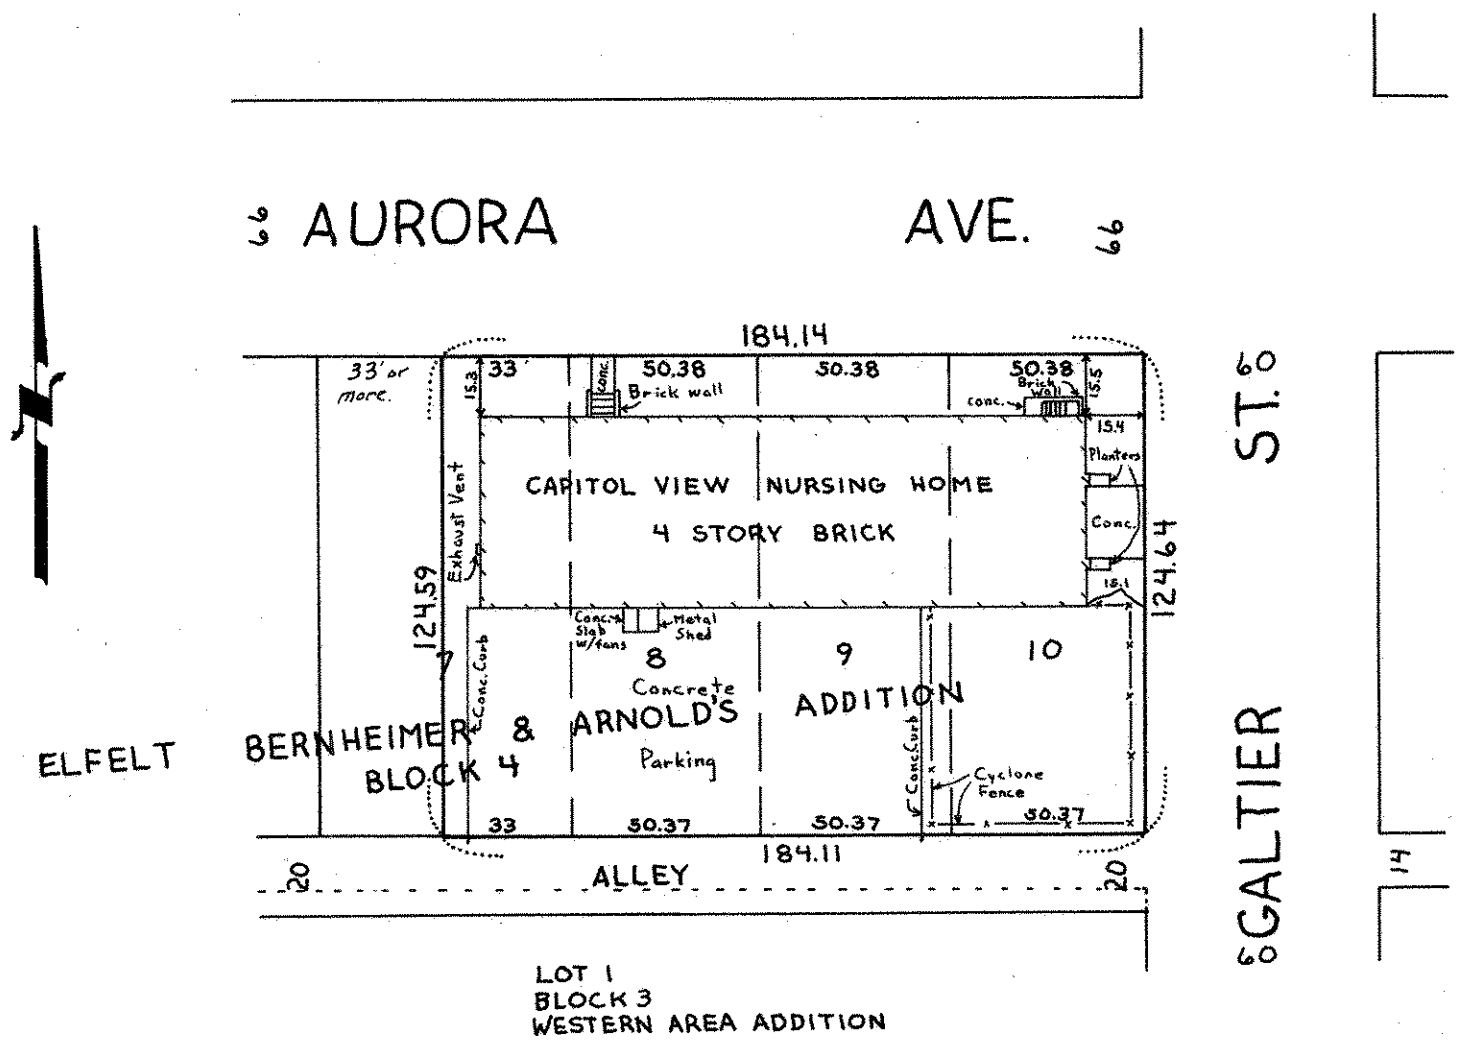

LOT 1
BLOCK 3
WESTERN AREA ADDITION