5E 34 29 23

FROM THE OFFICE OF

CHARLES O. GEORGI COMPANY

2215 West County Road B Saint Paul, Minnesota 55113

REGISTERED CIVIL ENGINEER AND LAND SURVEYOR

Certificate of Survey

I Hereby Certify that this plat shows a building location survey made by me on the property described on this plat, and that all locations, have been correctly shown.

9/72.

Date Concordia College

Scale 1" = 40'

By Charles O. Georgi
REGISTERED LAND SURVEYOR

Description:

The South 130 feet of the East 265 feet of Concordia College Campus, adjoining Marshall Ave. and Syndicate St., according to the recorded plat thereof. (December 1, 1924)

Ramsey County, Minnesota
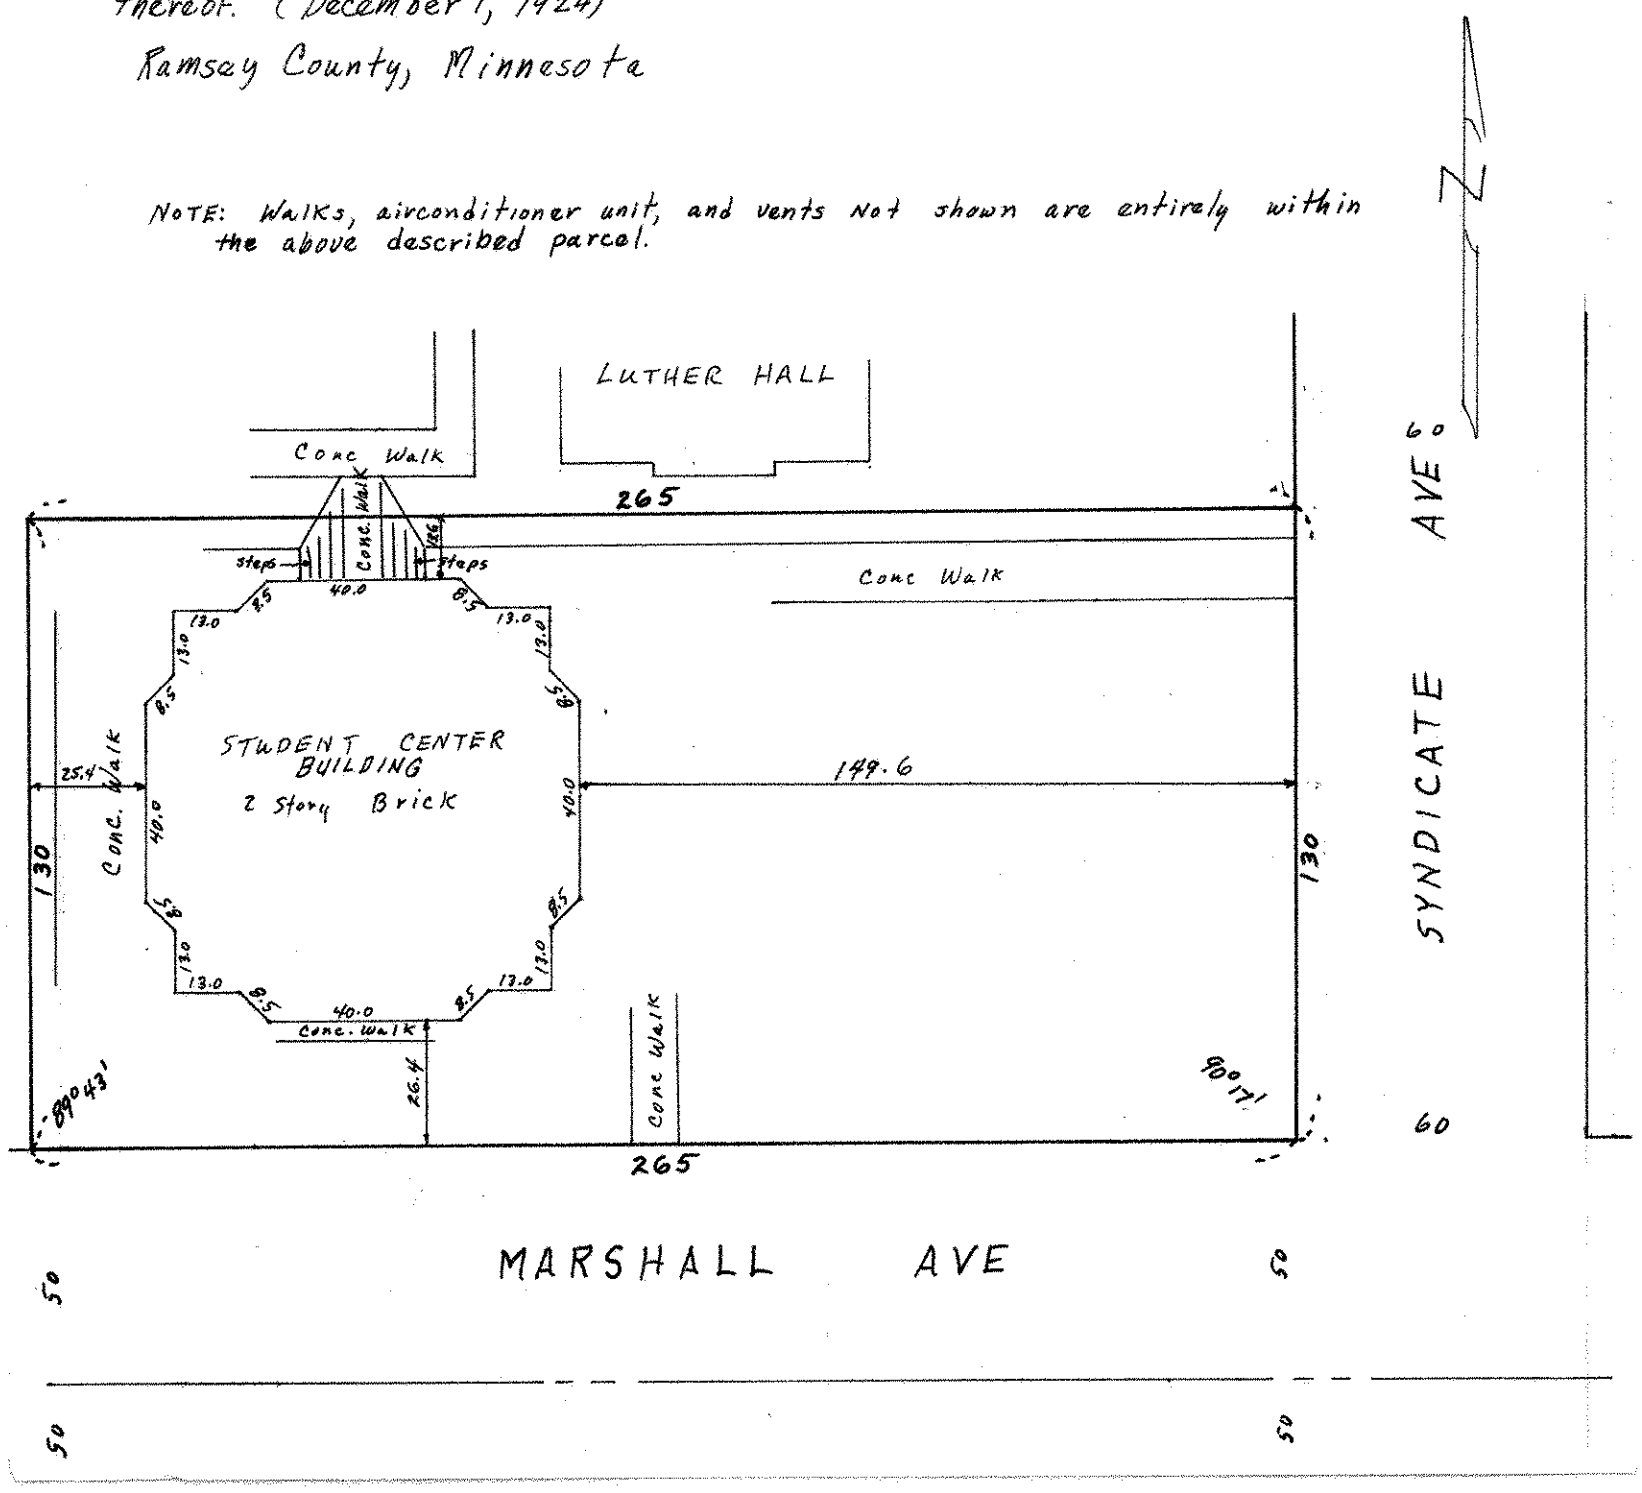
NOTE: Walks, airconditioner unit, and vents Not shown are entirely within the above described parcel.